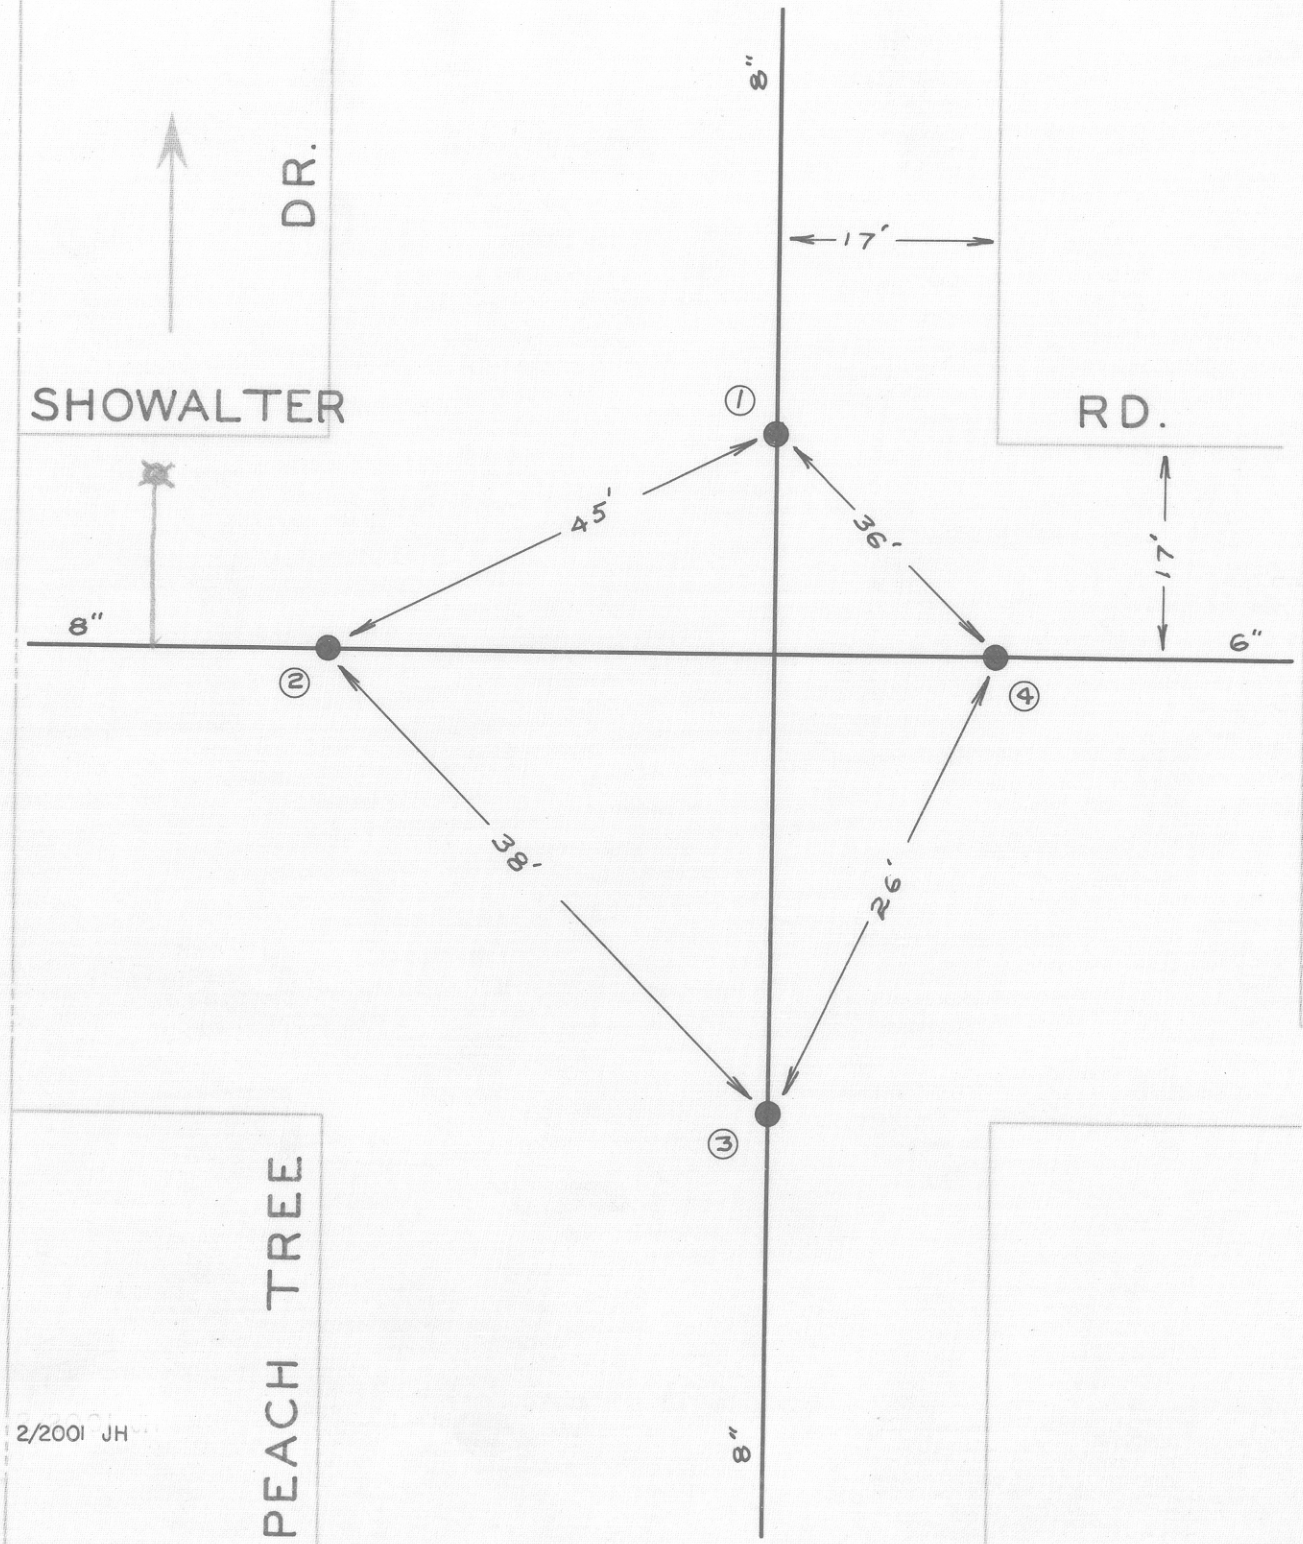

DATE	NO.	SIZE	MAKE	OPEN	TURNS
1954	1	8"			
1955	2	8"			
1954	3	8"			
1955	4	6"			
	1	0	NPL		
	2	0	WPL		
	3	0	SPL		
	4	0	EPL		

2/2001 JH

CITY OF ROANOKE—WATER DEP'T

VALVE DIAGRAM

PEACH TREE DR. &

SHOWALTER RD. N. W.

SEC. MAP 612 N. W.

DATE PAGE NO.