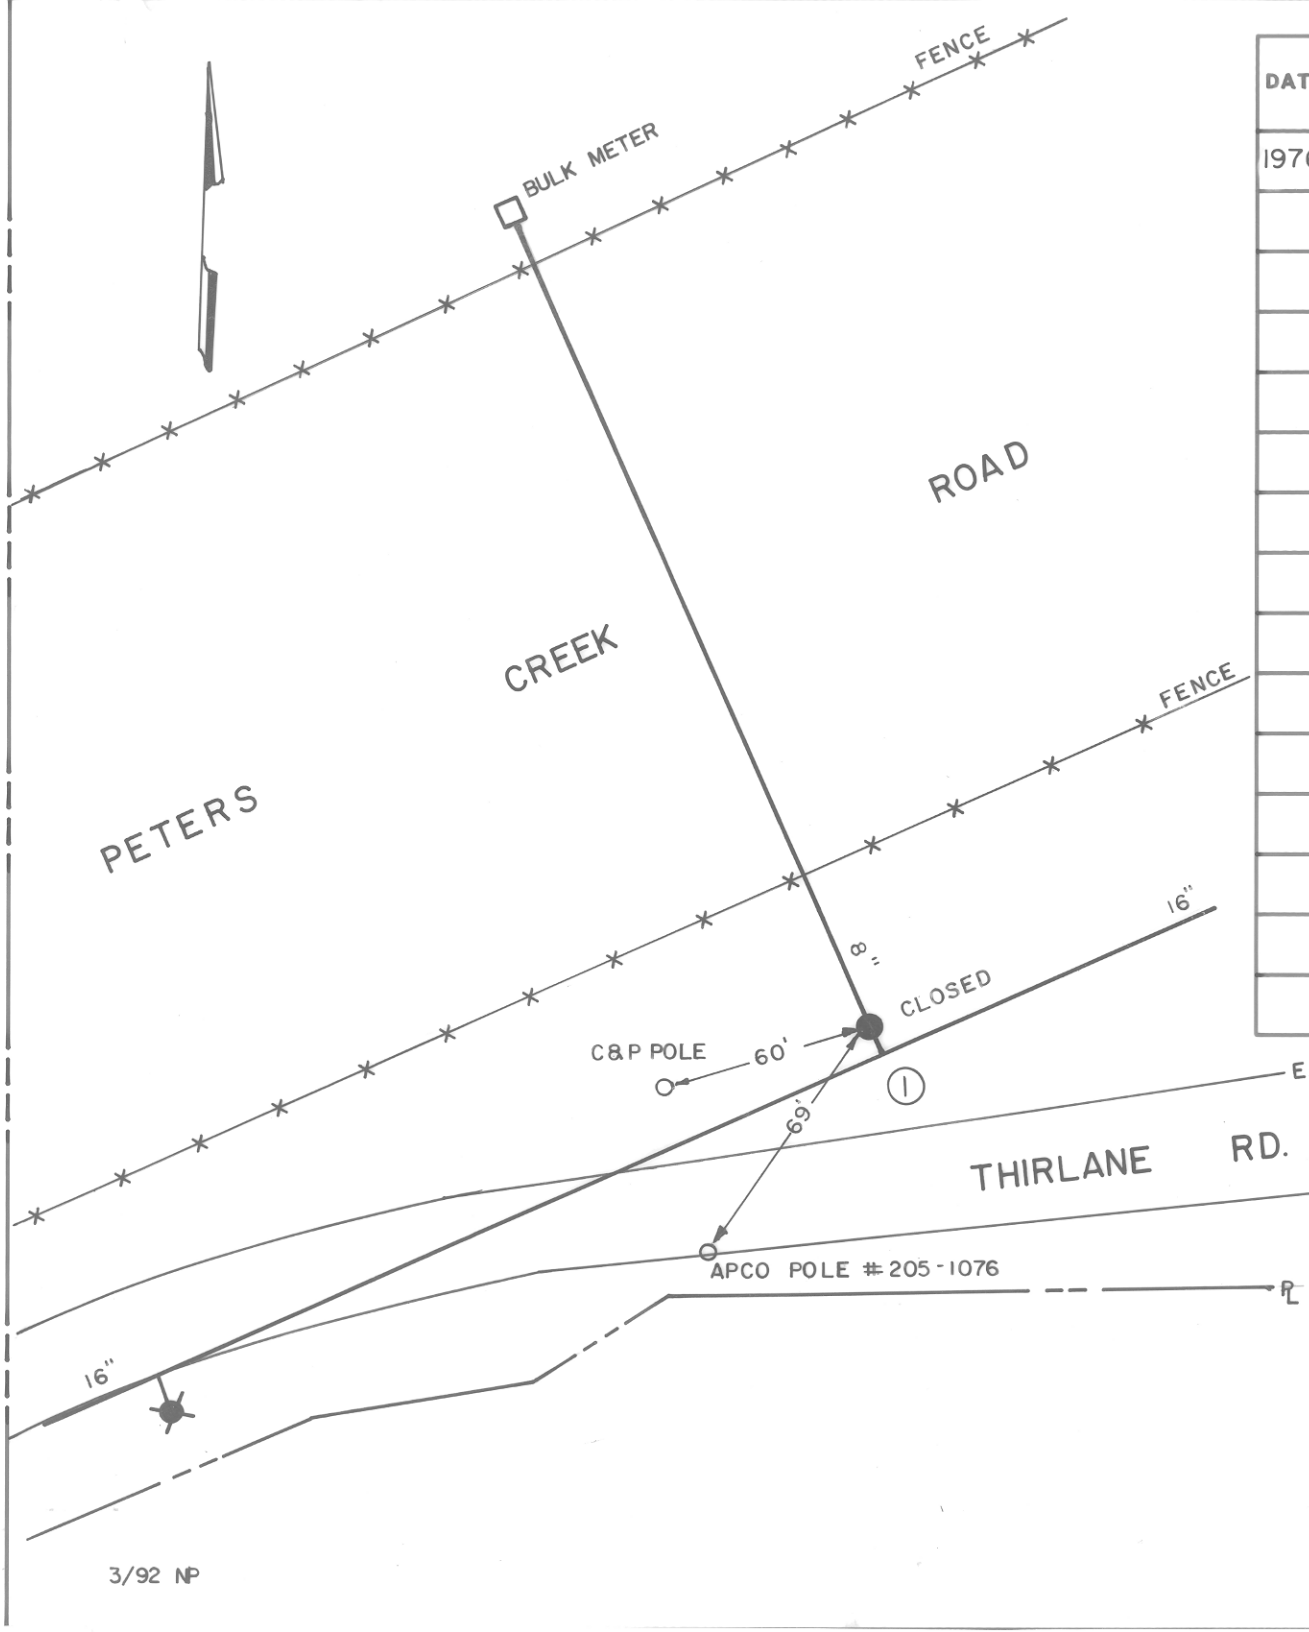

DATE	NO.	SIZE	MAKE	OPEN	TURNS
1976	1	8"			

CITY OF ROANOKE - WATER DEP'T.

VALVE DIAGRAM

PETERS CREEK ROAD,

THIRLANE ROAD

SEC. MAP 650, 658 N.W.

DATE: PAGE NO.