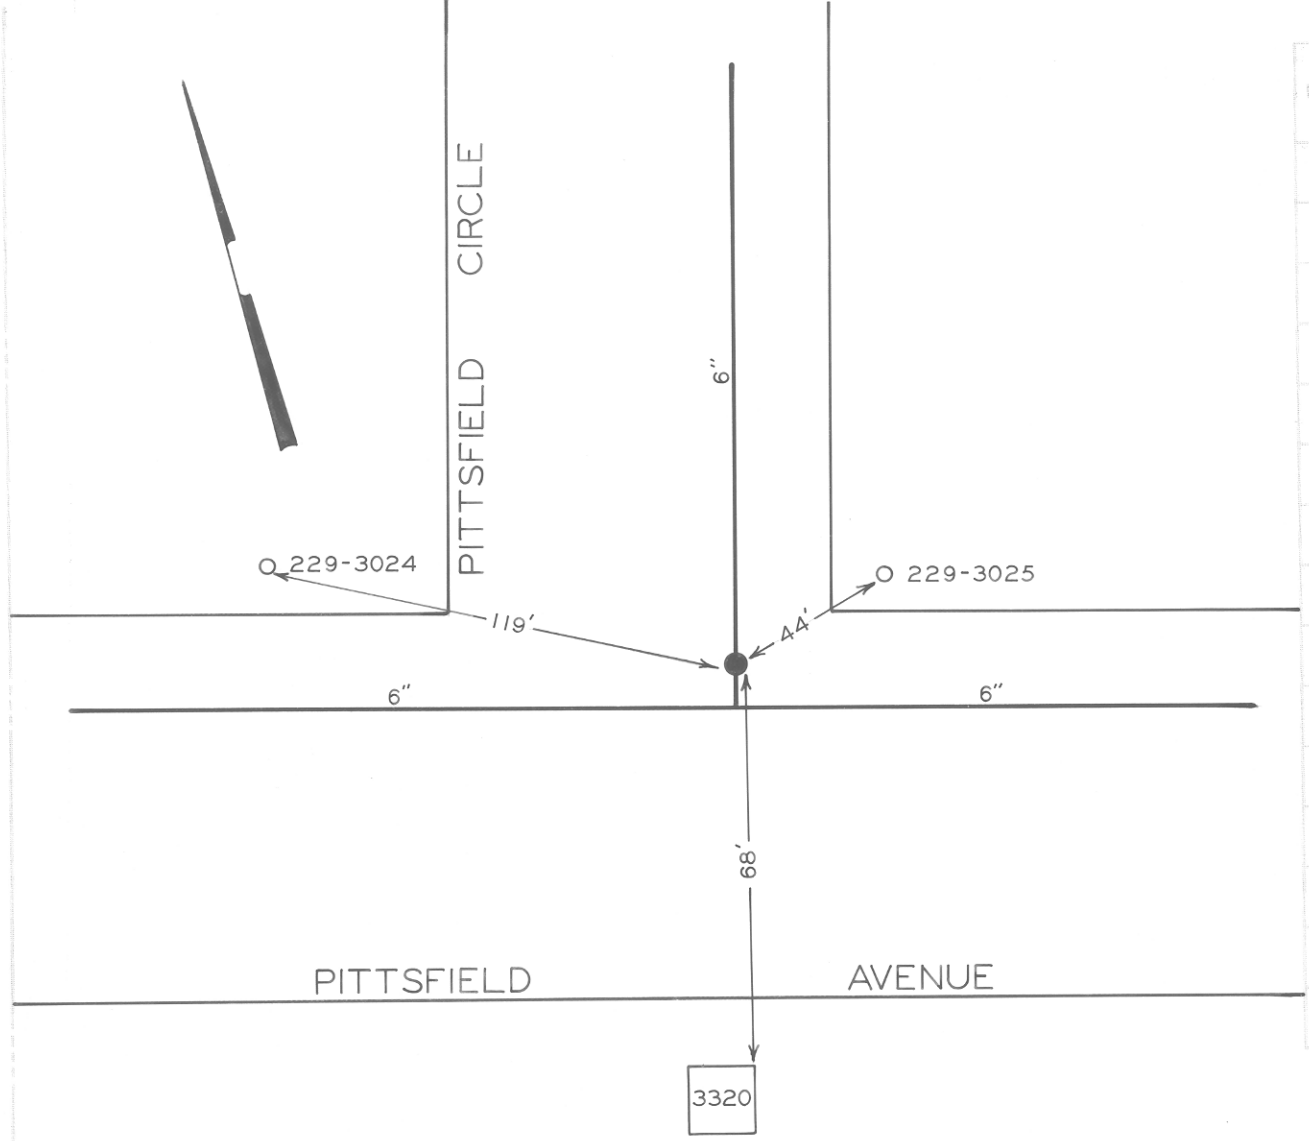

DATE	NO	SIZE	MAKE	OPEN	TURNS
73	1	6"	MUELLER	R	21

CITY OF ROANOKE—WATER DEP'T

VALVE DIAGRAM

PITTSFIELD AVENUE &
PITTSFIELD CIRCLE N.W.

SEC. MAP 256

DATE PAGE NO.

2/2001 JH