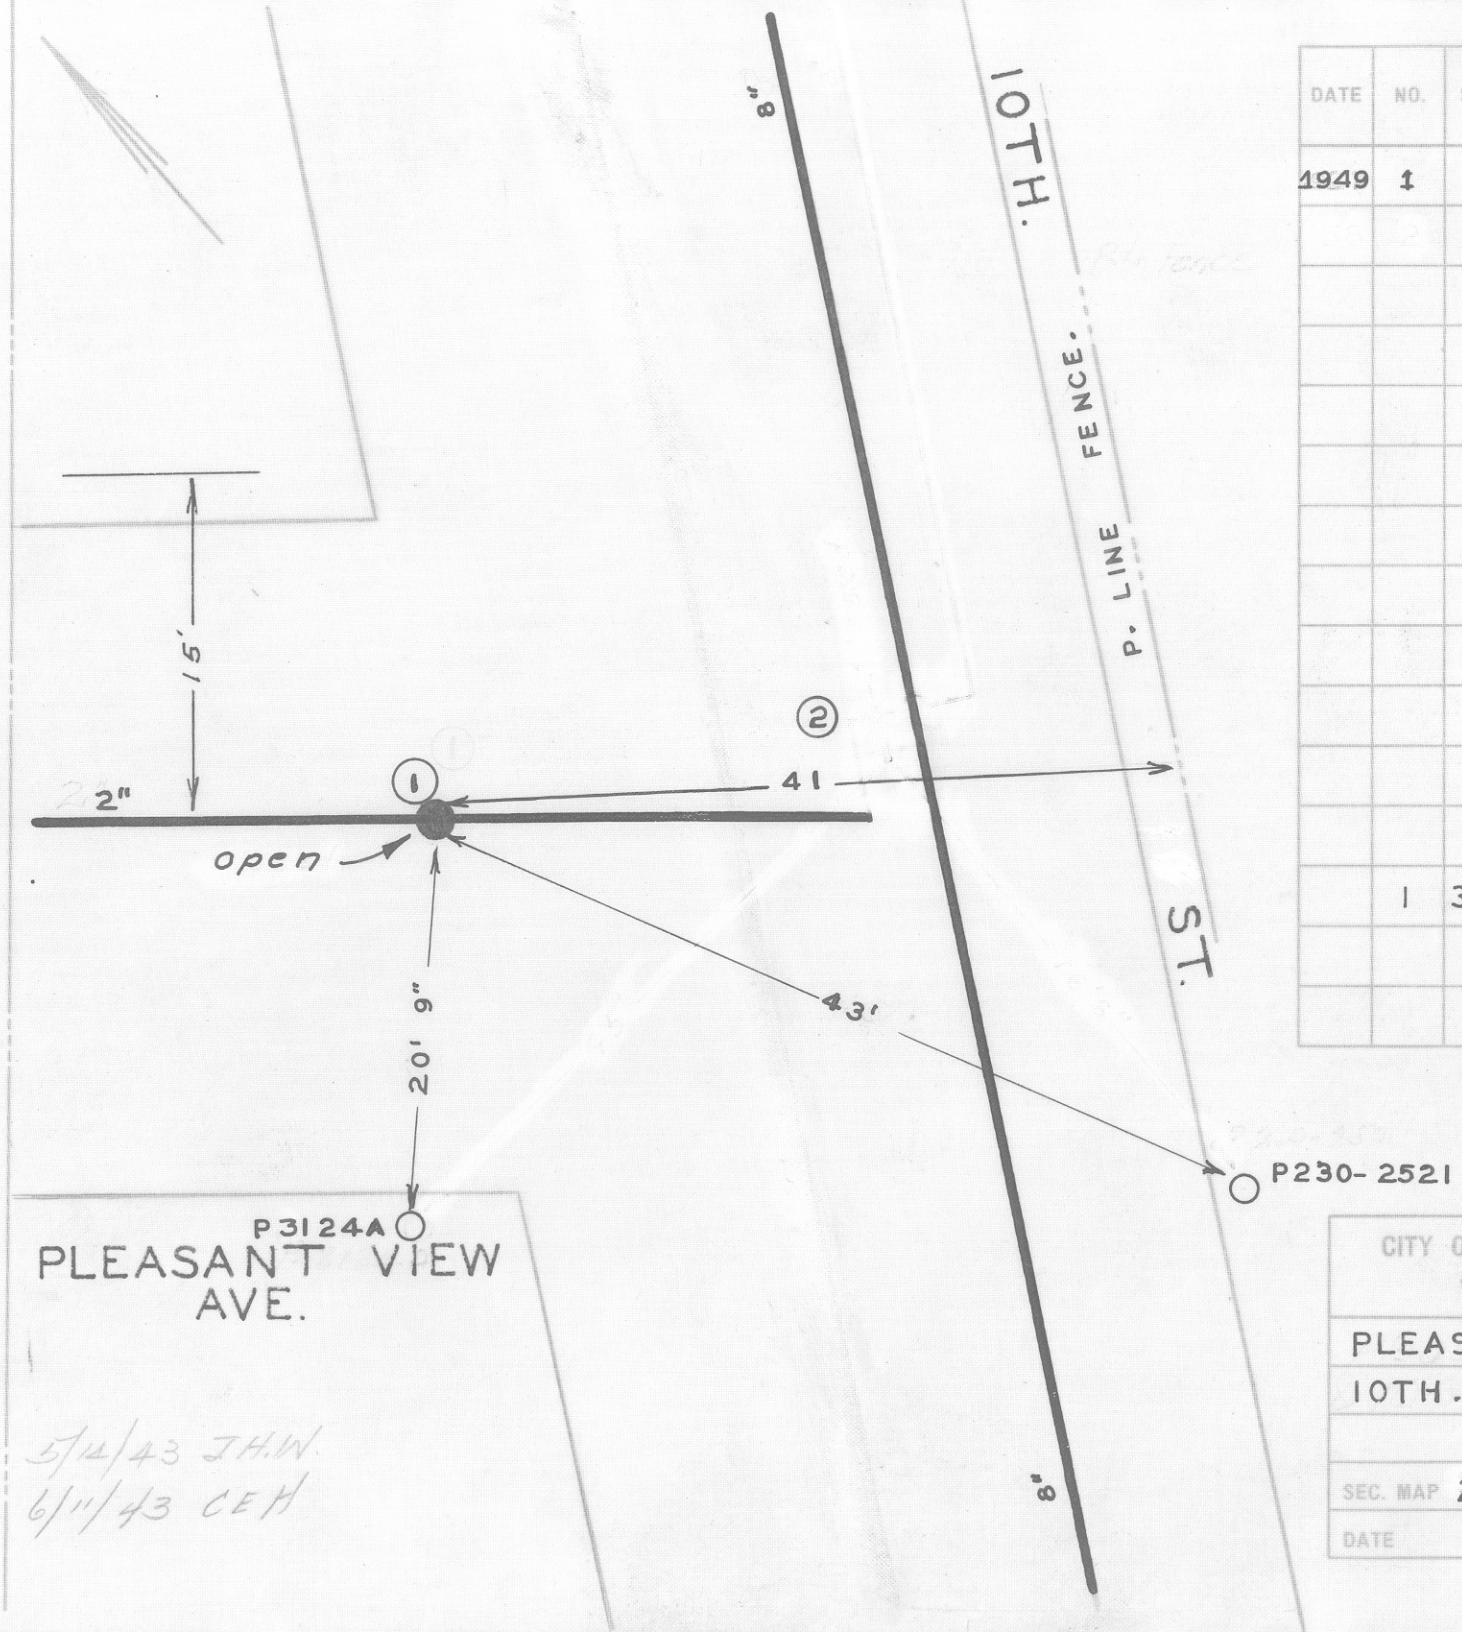

DATE	NO.	SIZE	MAKE	OPEN	TURNS
1949	1	2"	DARLING	R	7
	1	3'-E	WPL		

CITY OF ROANOKE—WATER DEP'T

VALVE DIAGRAM

PLEASANT VIEW AVE. & 10TH. ST. N. W.

SEC. MAP 214

DATE

PAGE NO NW. 66