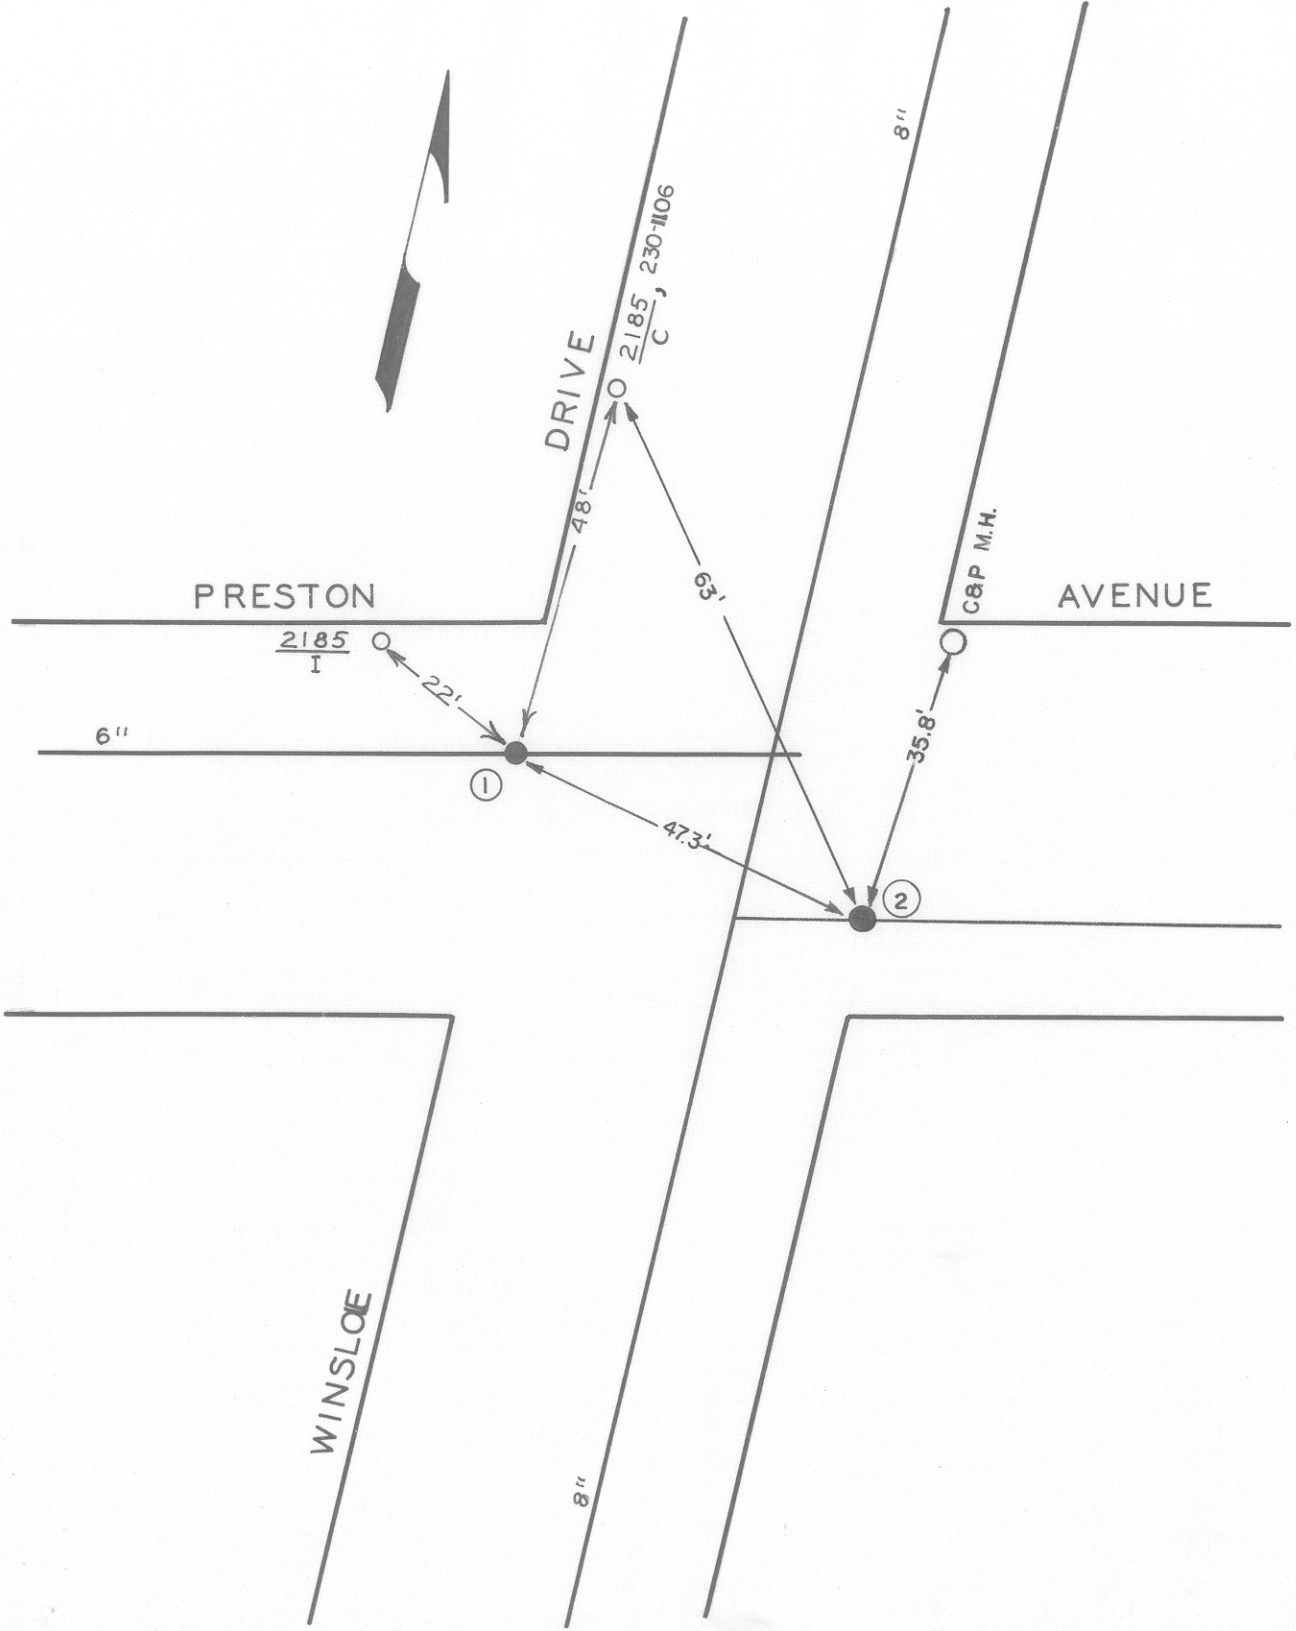

DATE	NO.	SIZE	MAKE	OPEN	TURNS
10-67	1	6	MUELLER	R	
1986	2	6"	MUELLER	R	
	1	0	W.P.L.		

CITY OF ROANOKE—WATER DEPT.

VALVE DIAGRAM

PRESTON AVENUE &

WINSLOE DRIVE N.W.

SEC. MAP 210

DATE **PAGE NO.**

2187
NP