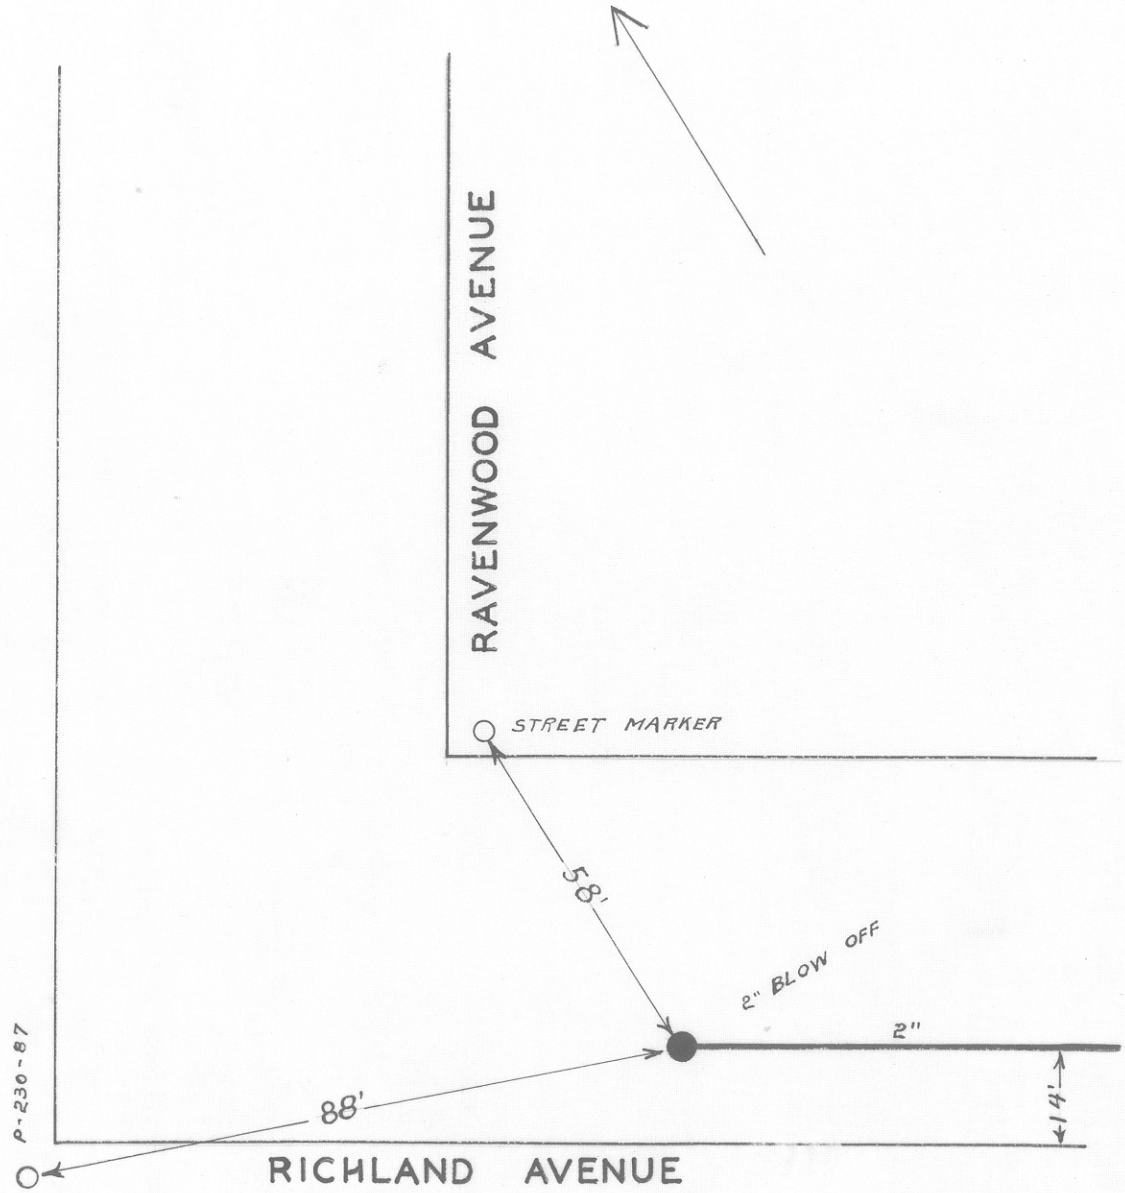

DATE	NO.	SIZE	MAKE	OPEN	TURNS
'60	1	2"	MISC.	L	
1	1	46'	E.E.P.L.		

CITY OF ROANOKE — WATER DEPT.

VALVE DIAGRAM

RAVENWOOD AVENUE &

RICHLAND AVENUE N.W.

SEC. MAP 216, 226 N.W.

DATE PAGE NO.

2/2001 JH

"IMPERIAL" TRACING CLOTH
K&E CO., N.Y.