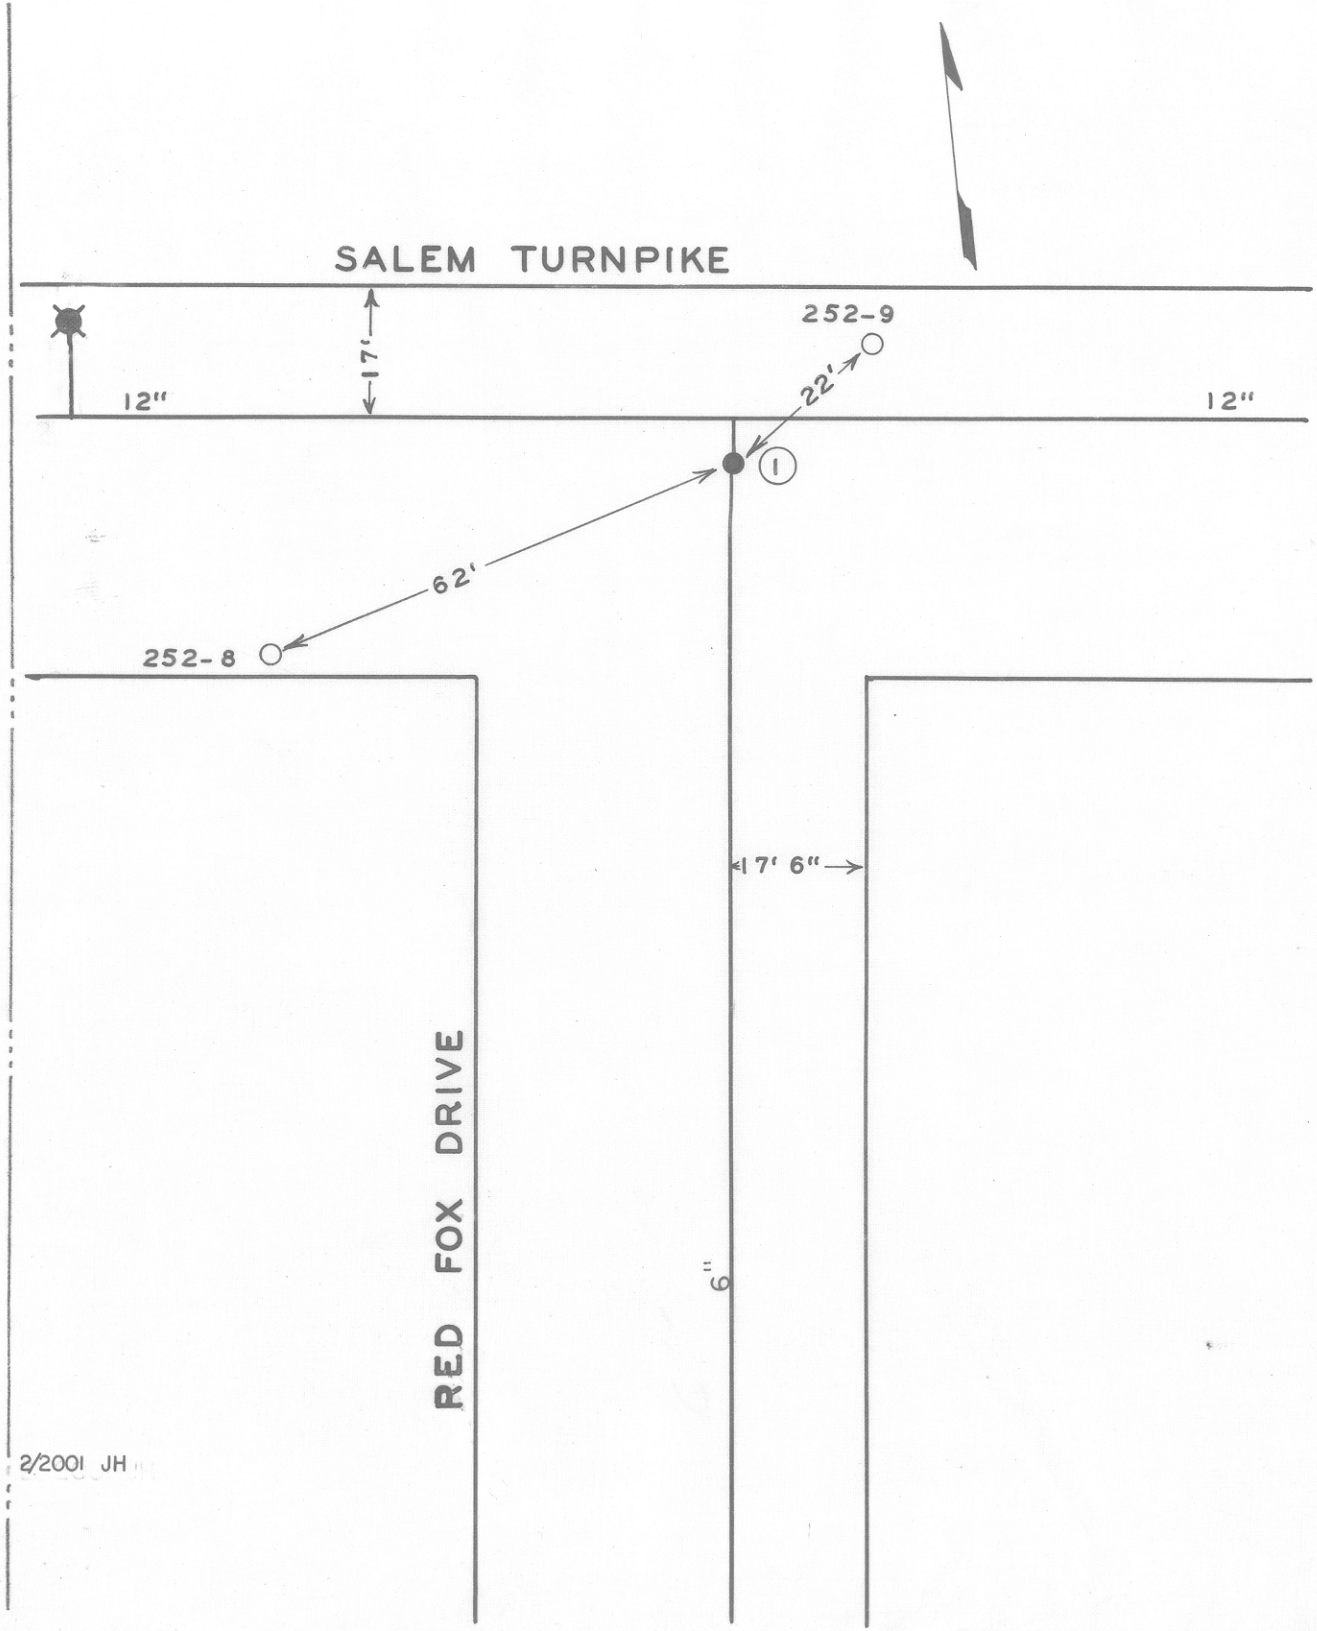


| DATE | NO. | SIZE | MAKE | OPEN | TURNS |
|---|---|---|---|---|---|
| 4-64 | 1 | 6" | DARLING | R | |
| | | | | | |
| | | | | | |
CITY OF ROANOKE—WATER DEPT.

**VALVE DIAGRAM**

RED FOX DRIVE &

SALEM TURNPIKE

SEC. MAP 274 N.W.

DATE PAGE NO.