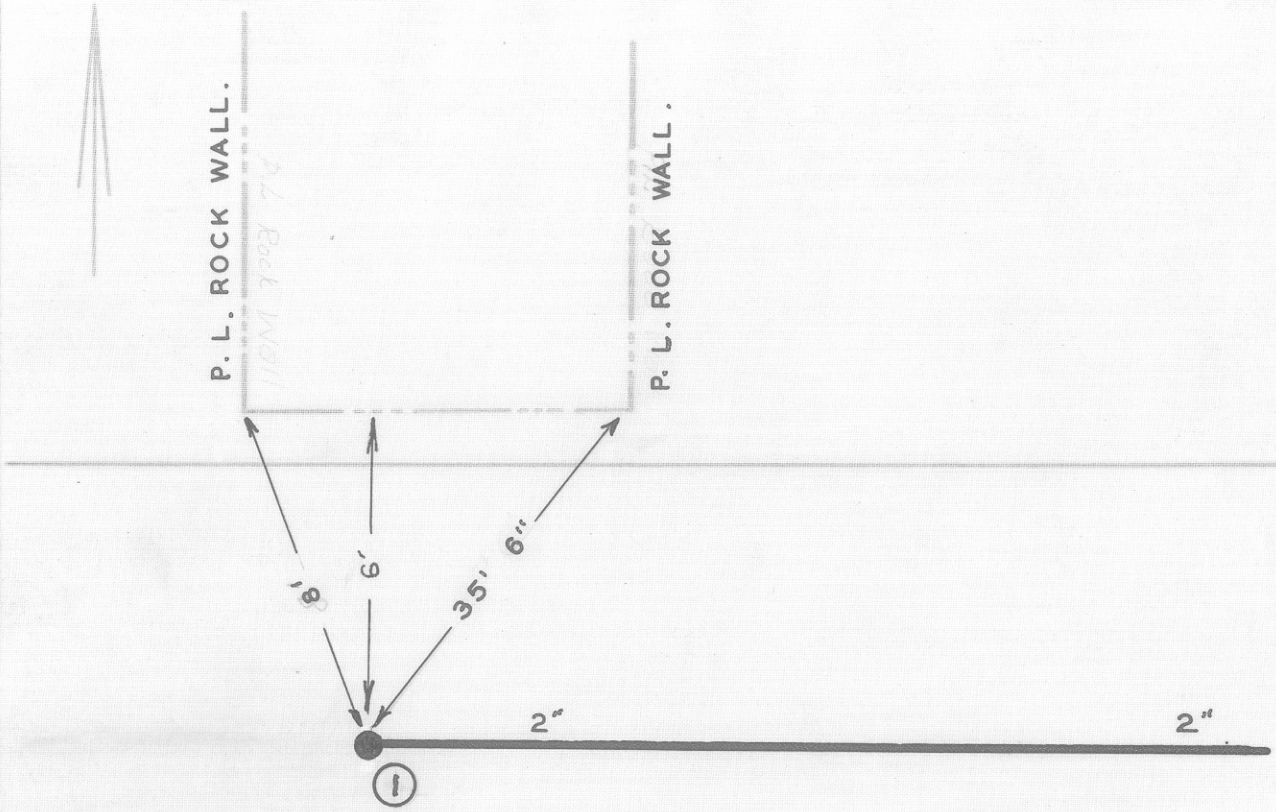

DATE	NO.	SIZE	MAKE	OPEN	TURNS
1927	1	2"	KEEP CLOSED		
	1	190'-W	WPL AT 11TH. ST.		

ROCKLAND AVE.

1/14/43 CEH

CITY OF ROANOKE—WATER DEP'T

VALVE DIAGRAM

2" BLOW OFF VALVE AT END OF MAIN IN ROCKLAND AVE. W. OF 10TH. ST. N. W.

SEC. MAP 204

DATE

PAGE NO. N.W. 64