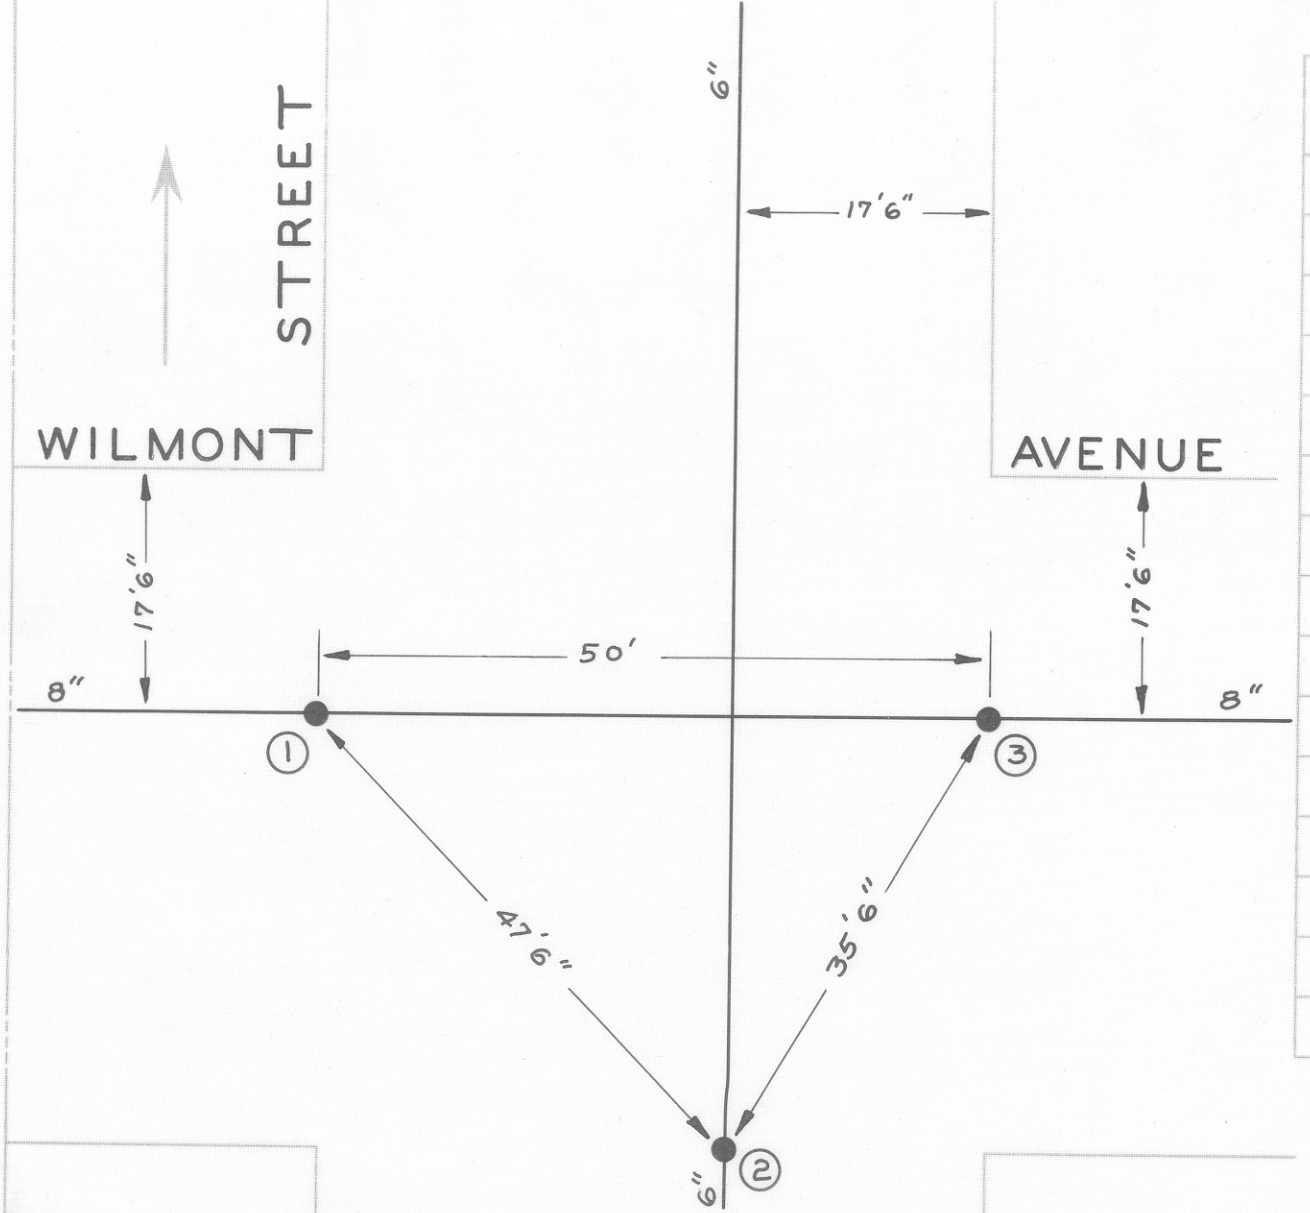

DATE	NO.	SIZE	MAKE	OPEN	TURNS
'58	1	8"	MUELLER	R	28
'58	2	6"	MUELLER	R	20
'58	3	8"	MUELLER	R	28
	1	0	WPL		
	2	0	SPL		
	3	0	EPL		

2/2001 JH

CITY OF ROANOKE—WATER DEP'T

VALVE DIAGRAM

ROSEMEAD STREET &

WILMONT AVE. N.W.

SEC. MAP 273 N.W.

DATE PAGE NO.