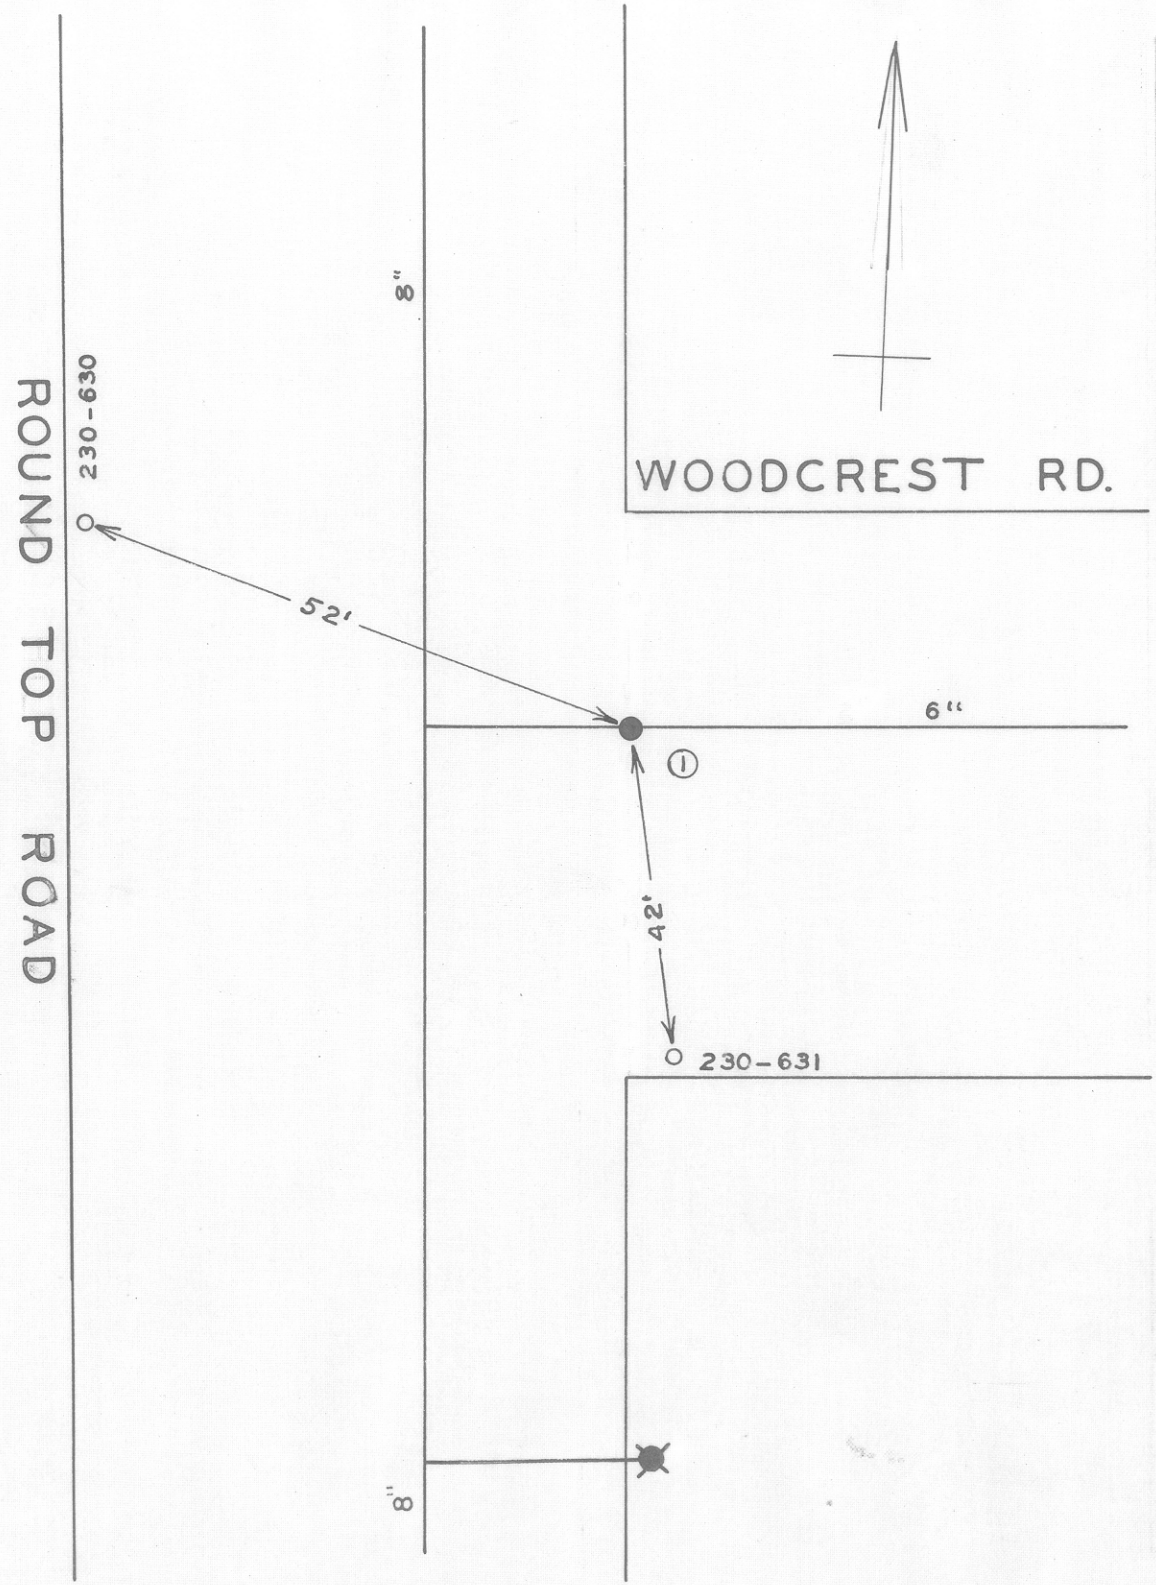

DATE	NO.	SIZE	MAKE	OPEN	TURNS
1964	1	6"	MUELLER	R	
	1	0	EPL		

CITY OF ROANOKE—WATER DEPT.

VALVE DIAGRAM

ROUND TOP ROAD &

WOOD CREST RD.

SEC. MAP 215, 225 N.W.

DATE PAGE NO.

2/2001 JH

2/2001 JH

IMPERIAL TRACING CLOTH
H. & B. CO., N.Y.