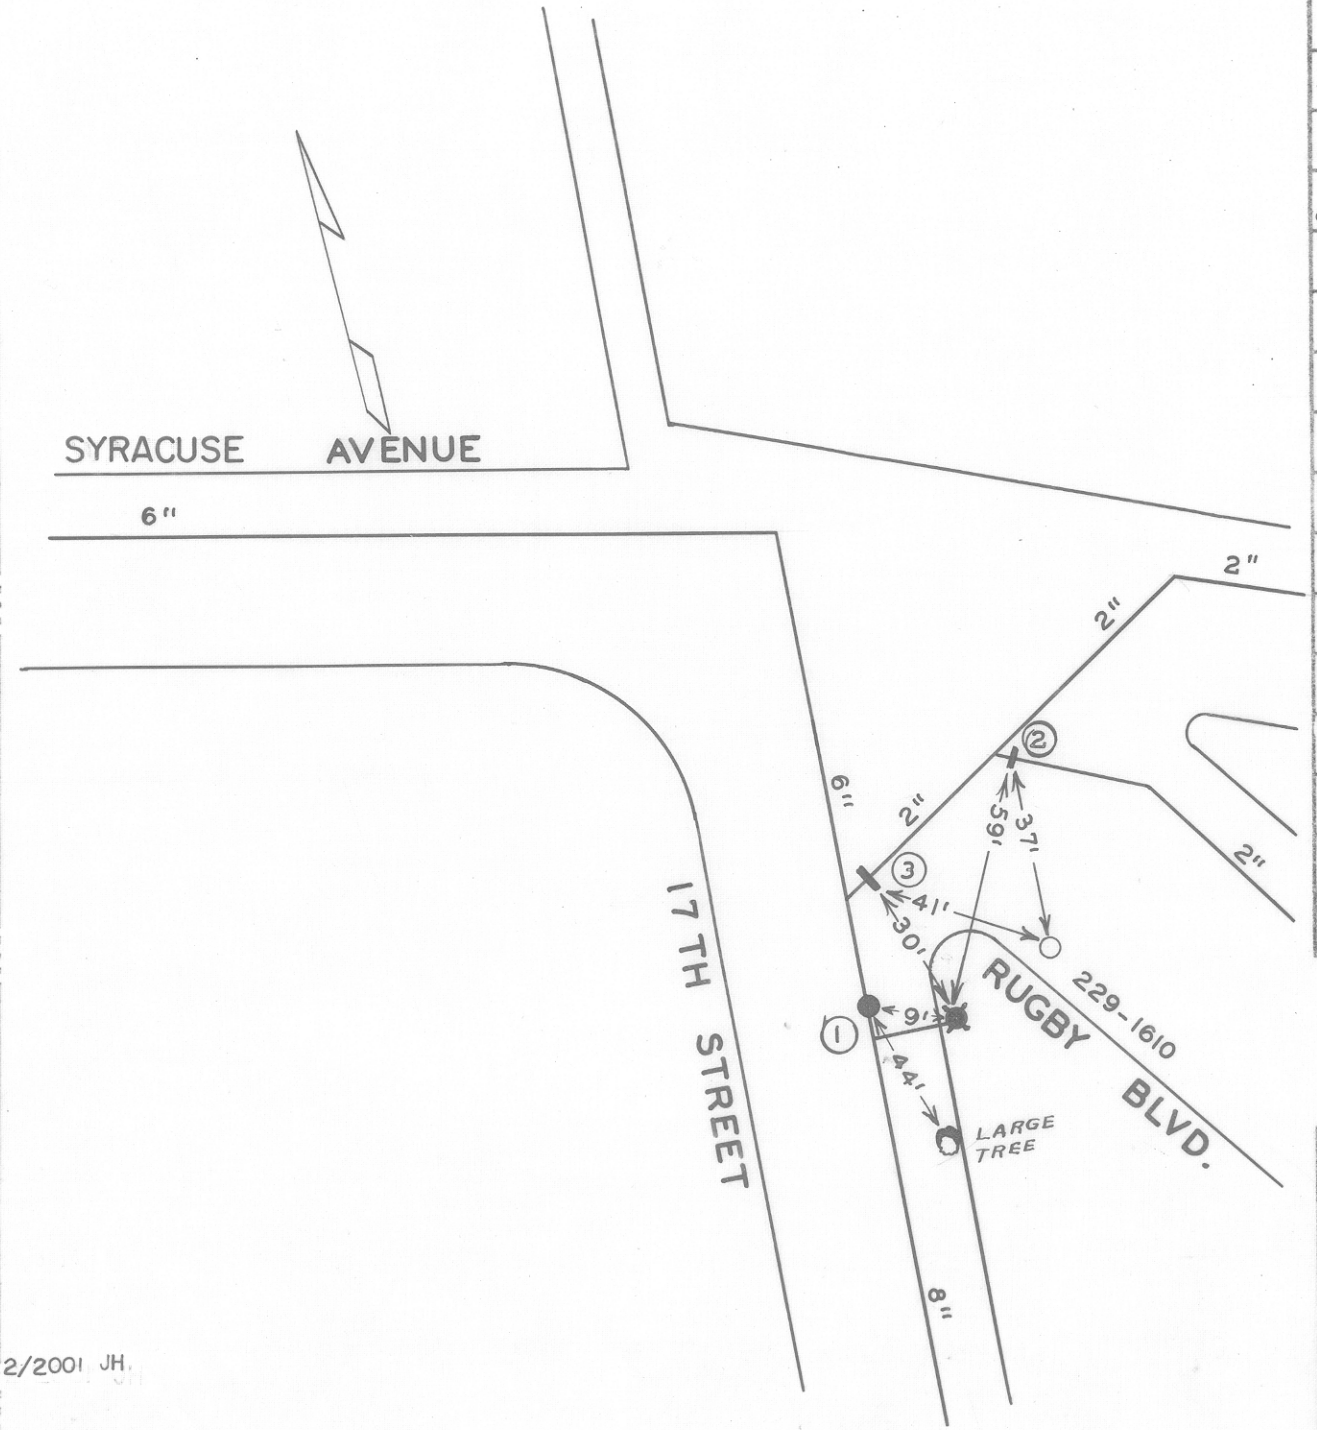

DATE	NO.	SIZE	MAKE	OPEN	TURNS
7-62	1	6"	DARLING	R	21
8-62	2	2"	DARLING	R	
8-62	3	2"	DARLING	R	

2/2001 JH

CITY OF ROANOKE — WATER DEPT.

VALVE DIAGRAM

RUGBY BLVD.,

SYRACUSE AVENUE &

17 TH STREET

SEC. MAP 234 233 N.W.

DATE PAGE NO.