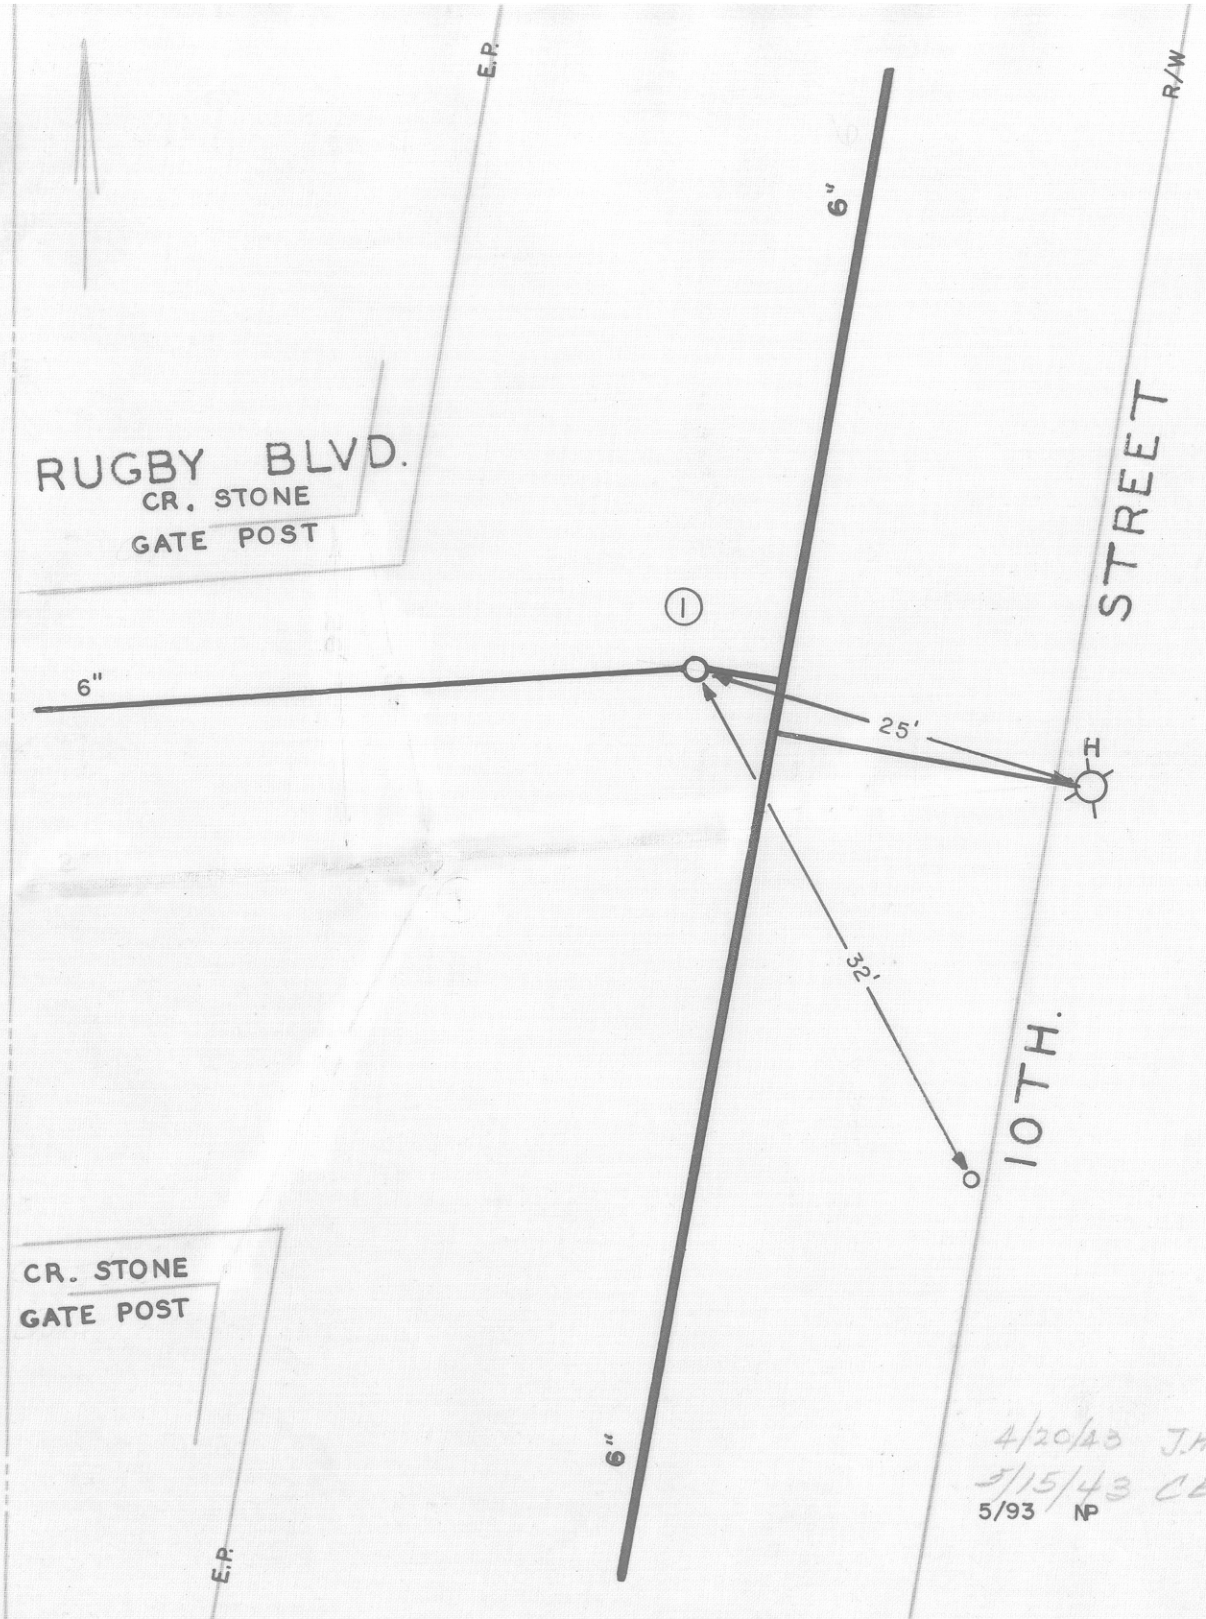

DATE	NO.	SIZE	MAKE	OPEN	TURNS
9-92	1	6"	MUELLER	R	19

4/20/43 J.H.W.
5/15/43 CEH
5/93 NP

CITY OF ROANOKE—WATER DEP'T
VALVE DIAGRAM
RUGBY BLVD. & 10TH.
ST. N.W.

SEC. MAP 223
DATE PAGE NO. NW.169