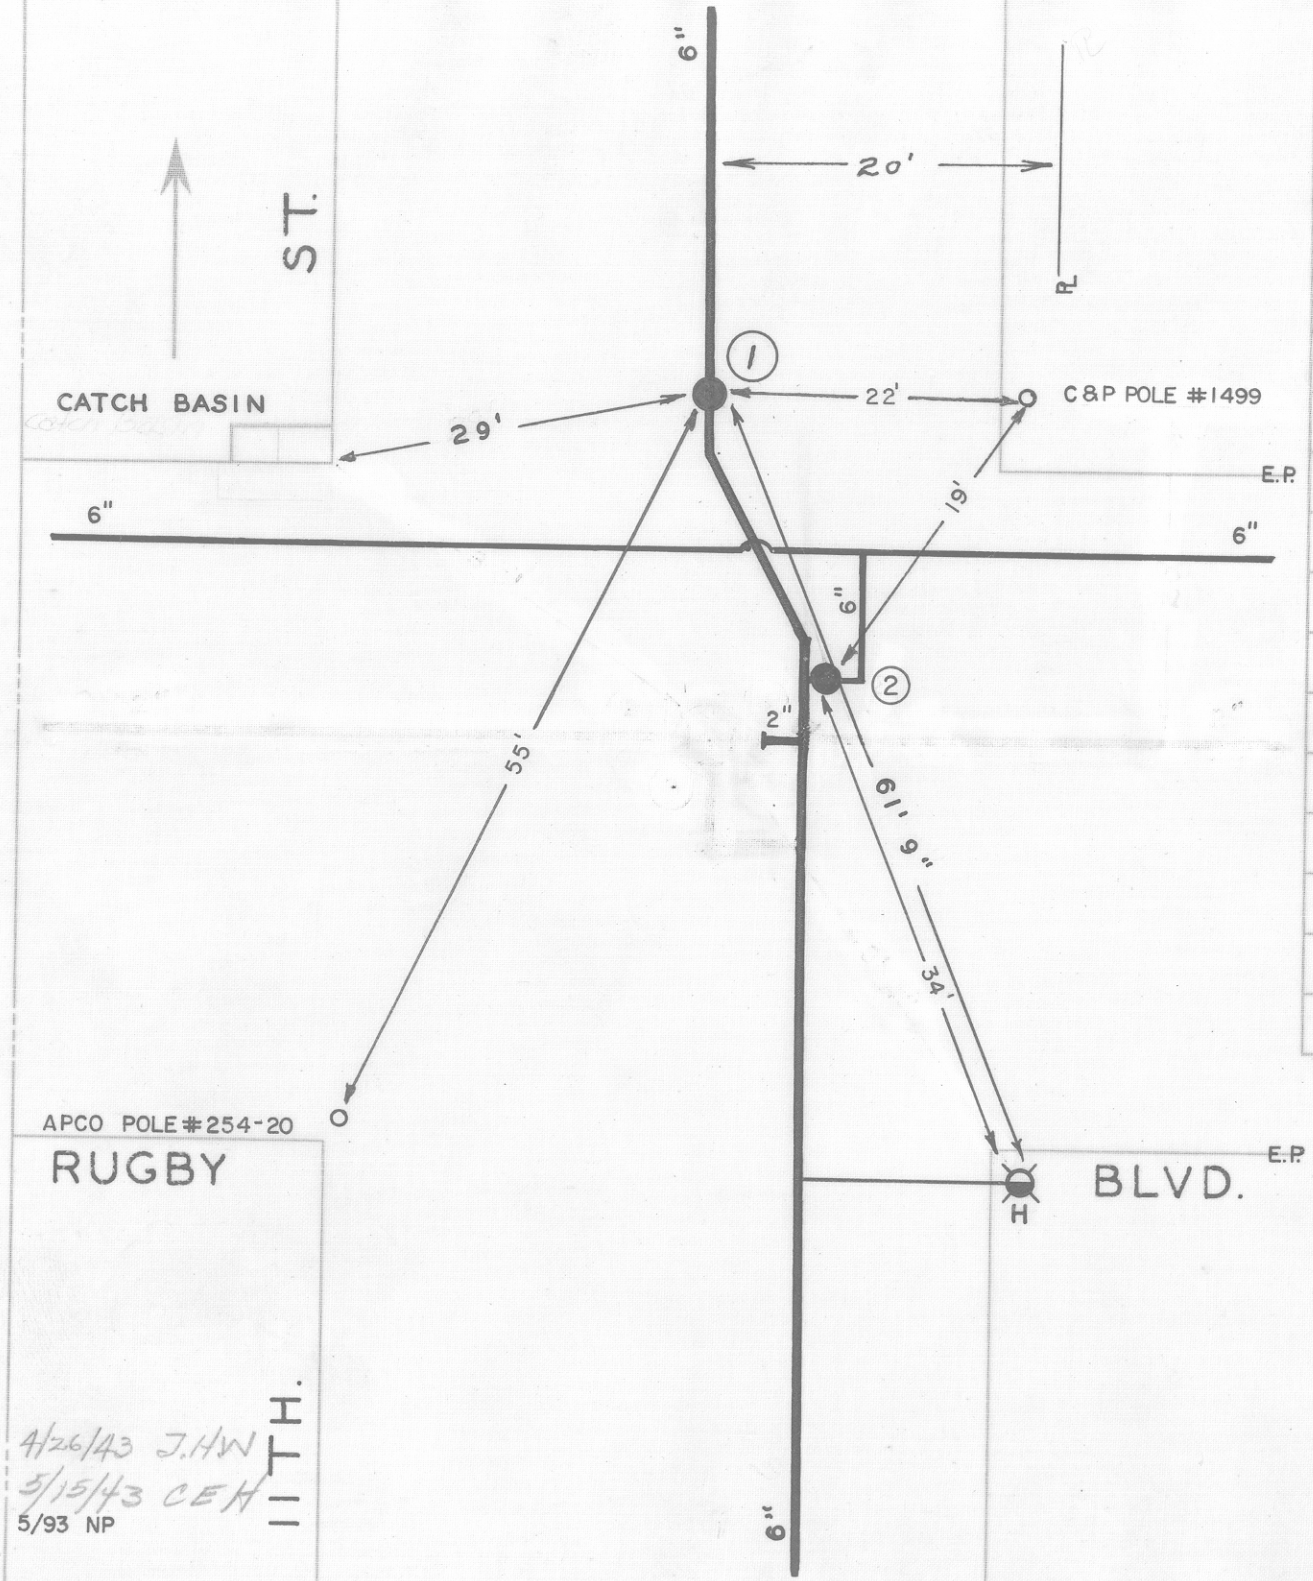

DATE	NO.	SIZE	MAKE	OPEN	TURNS
1939	1	6"		R	20
9-92	2	6"	MUELLER	R	19
	1	0	NPL		

4/26/43 J.HW
5/15/43 CEH
5/93 NP

CITY OF ROANOKE—WATER DEP'T
VALVE DIAGRAM
RUGBY BLVD & 11TH.
ST. N.W.

SEC. MAP 223
DATE
PAGE NO. N.W. 170