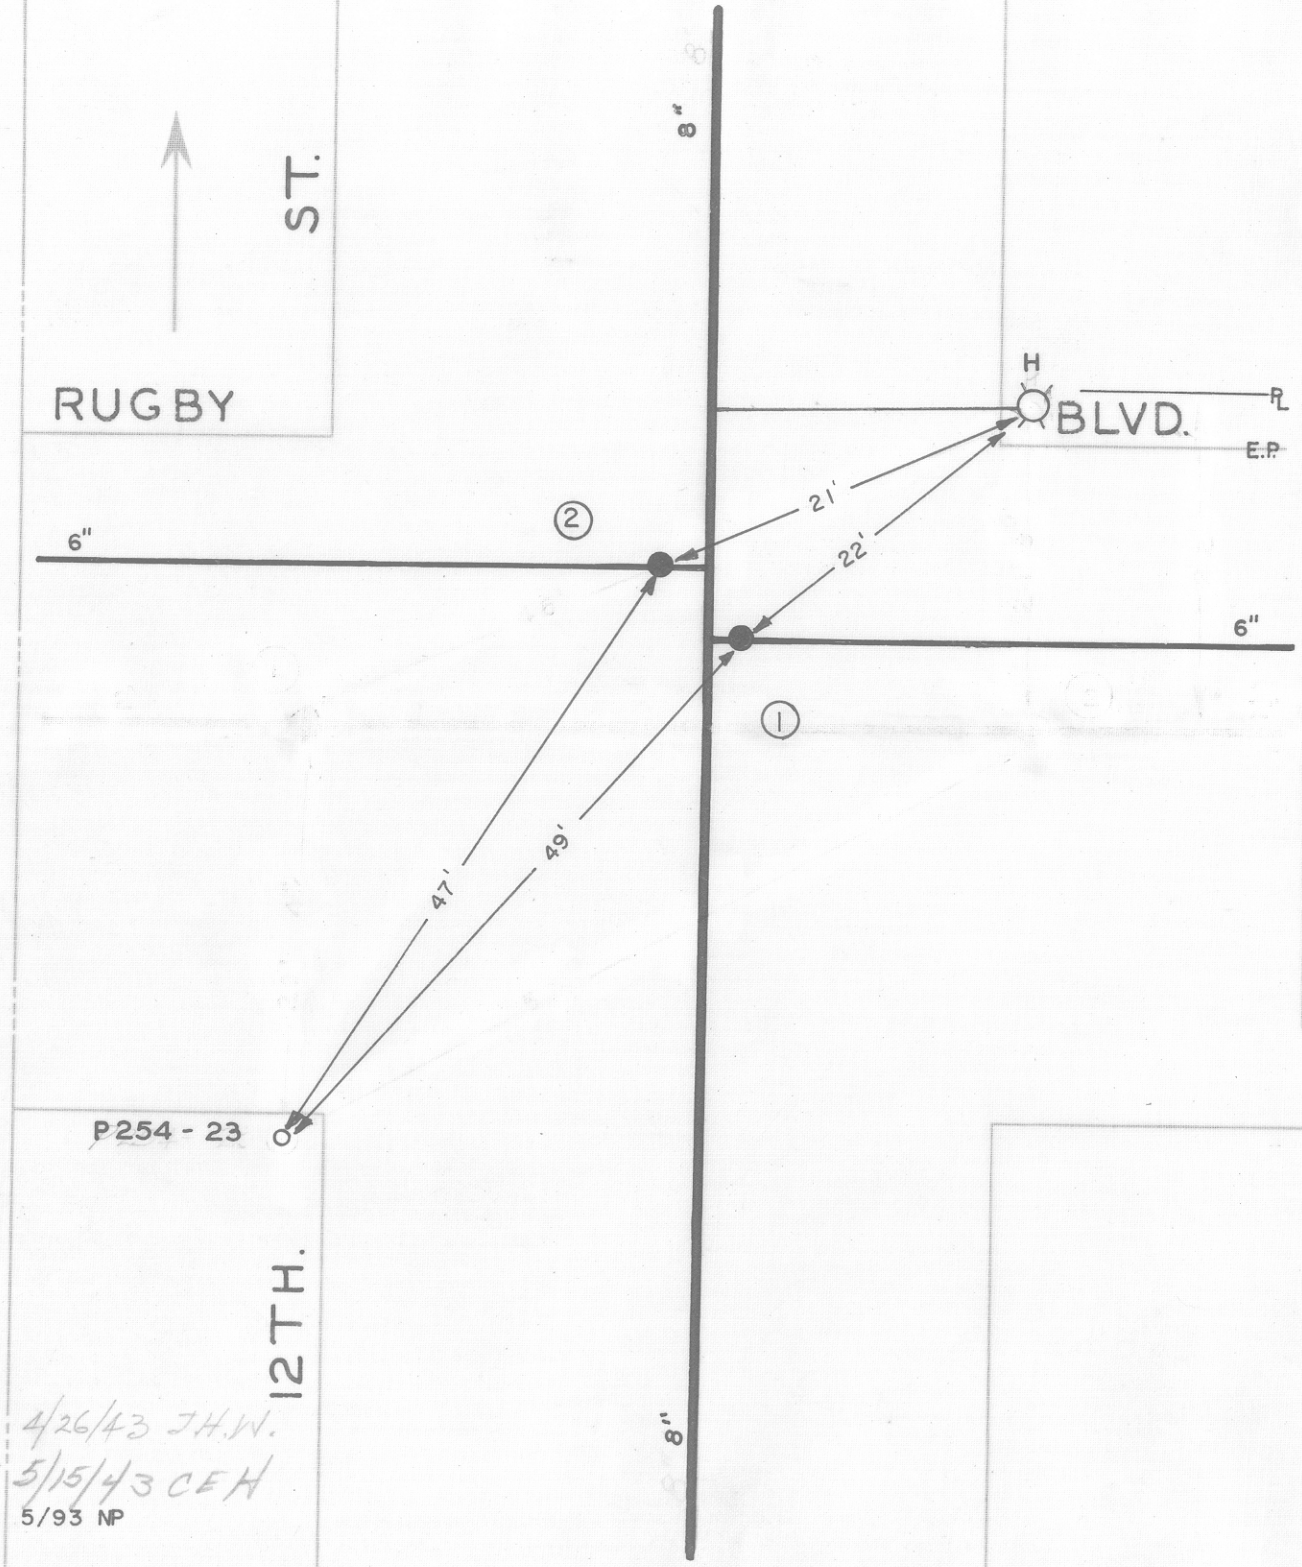

4/26/43 J.H.W.
5/15/43 CEH
5/93 NP

DATE	NO.	SIZE	MAKE	OPEN	TURNS
9-92	1	6"	MUELLER	R	21
9-92	2	6"	MUELLER	R	21

CITY OF ROANOKE—WATER DEP'T
VALVE DIAGRAM
RUGBY BLVD. & 12TH. ST. N. W.

SEC. MAP 223
DATE
PAGE NO. N.W. 171