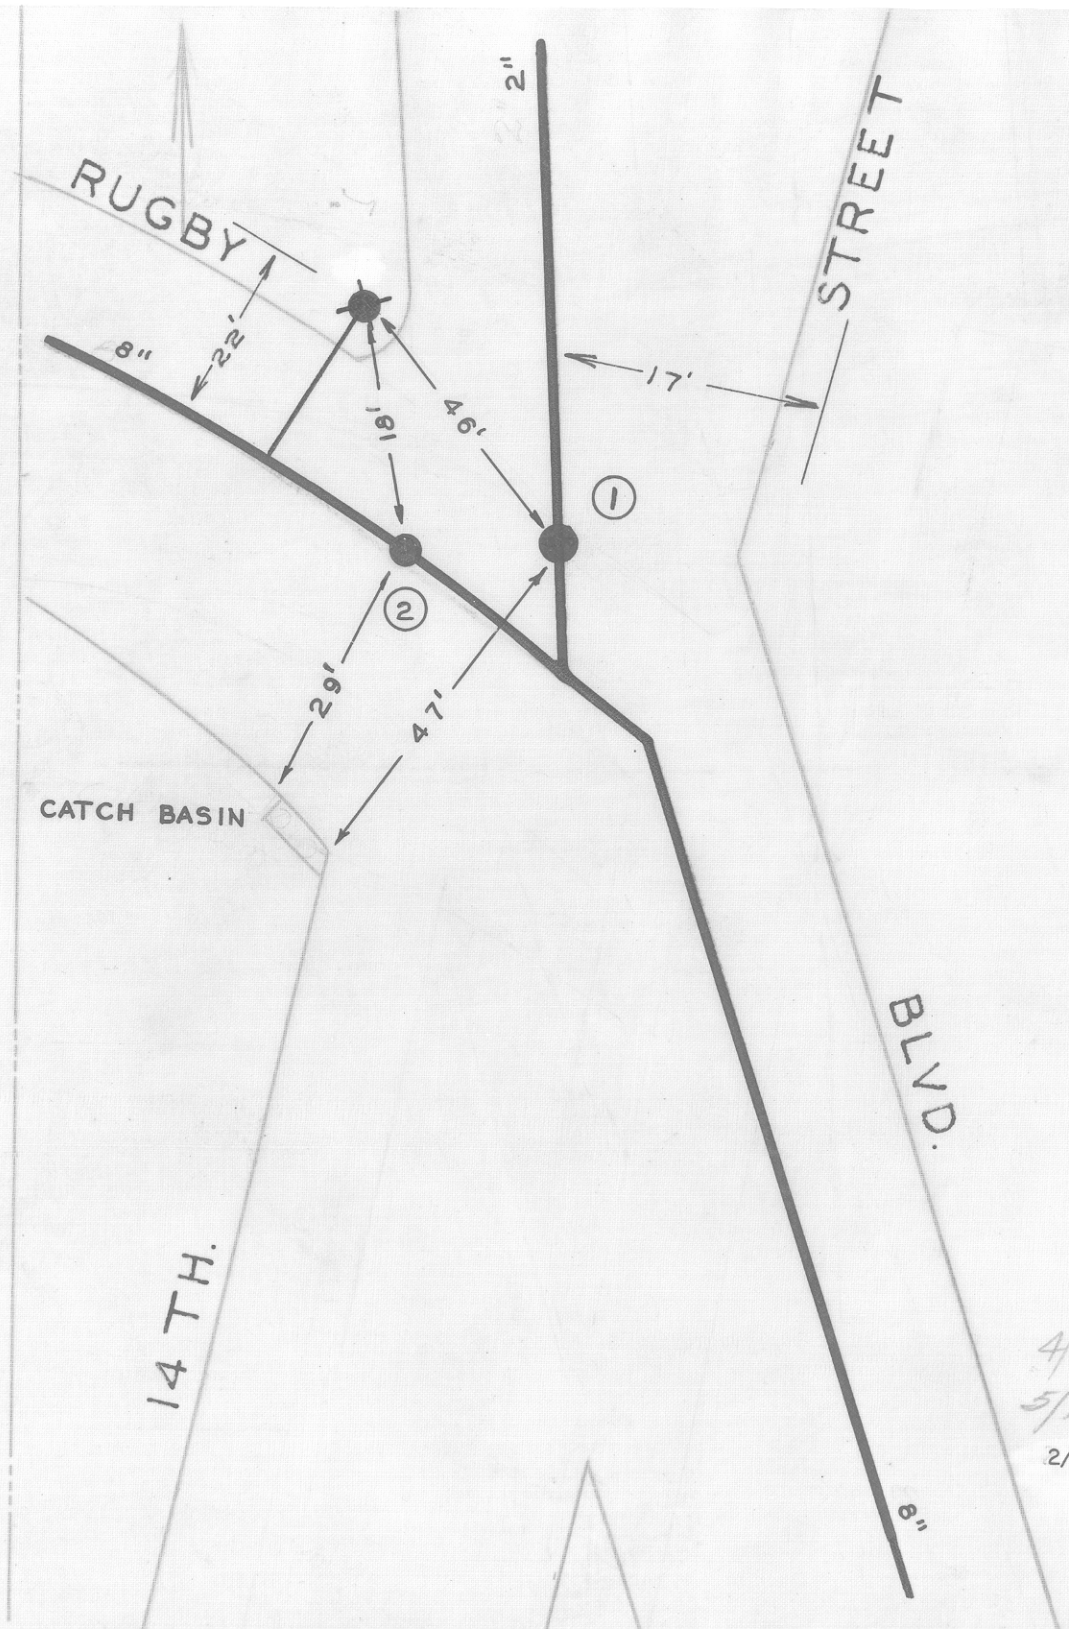

DATE	NO.	SIZE	MAKE	OPEN	TURNS
1919	1	2"		L	7
1939	2	8"		R	27
	1	22'-S	NPL		
	2	9'-E	WPL		

4/26/43 JHW
5/15/42 CEH
2/2001. JH

CITY OF ROANOKE—WATER DEP'T
VALVE DIAGRAM

RUGBY BLVD. & 14 TH.
14 TH STREET

SEC. MAP 223 N.W.

DATE PAGE NO. N.W. 173