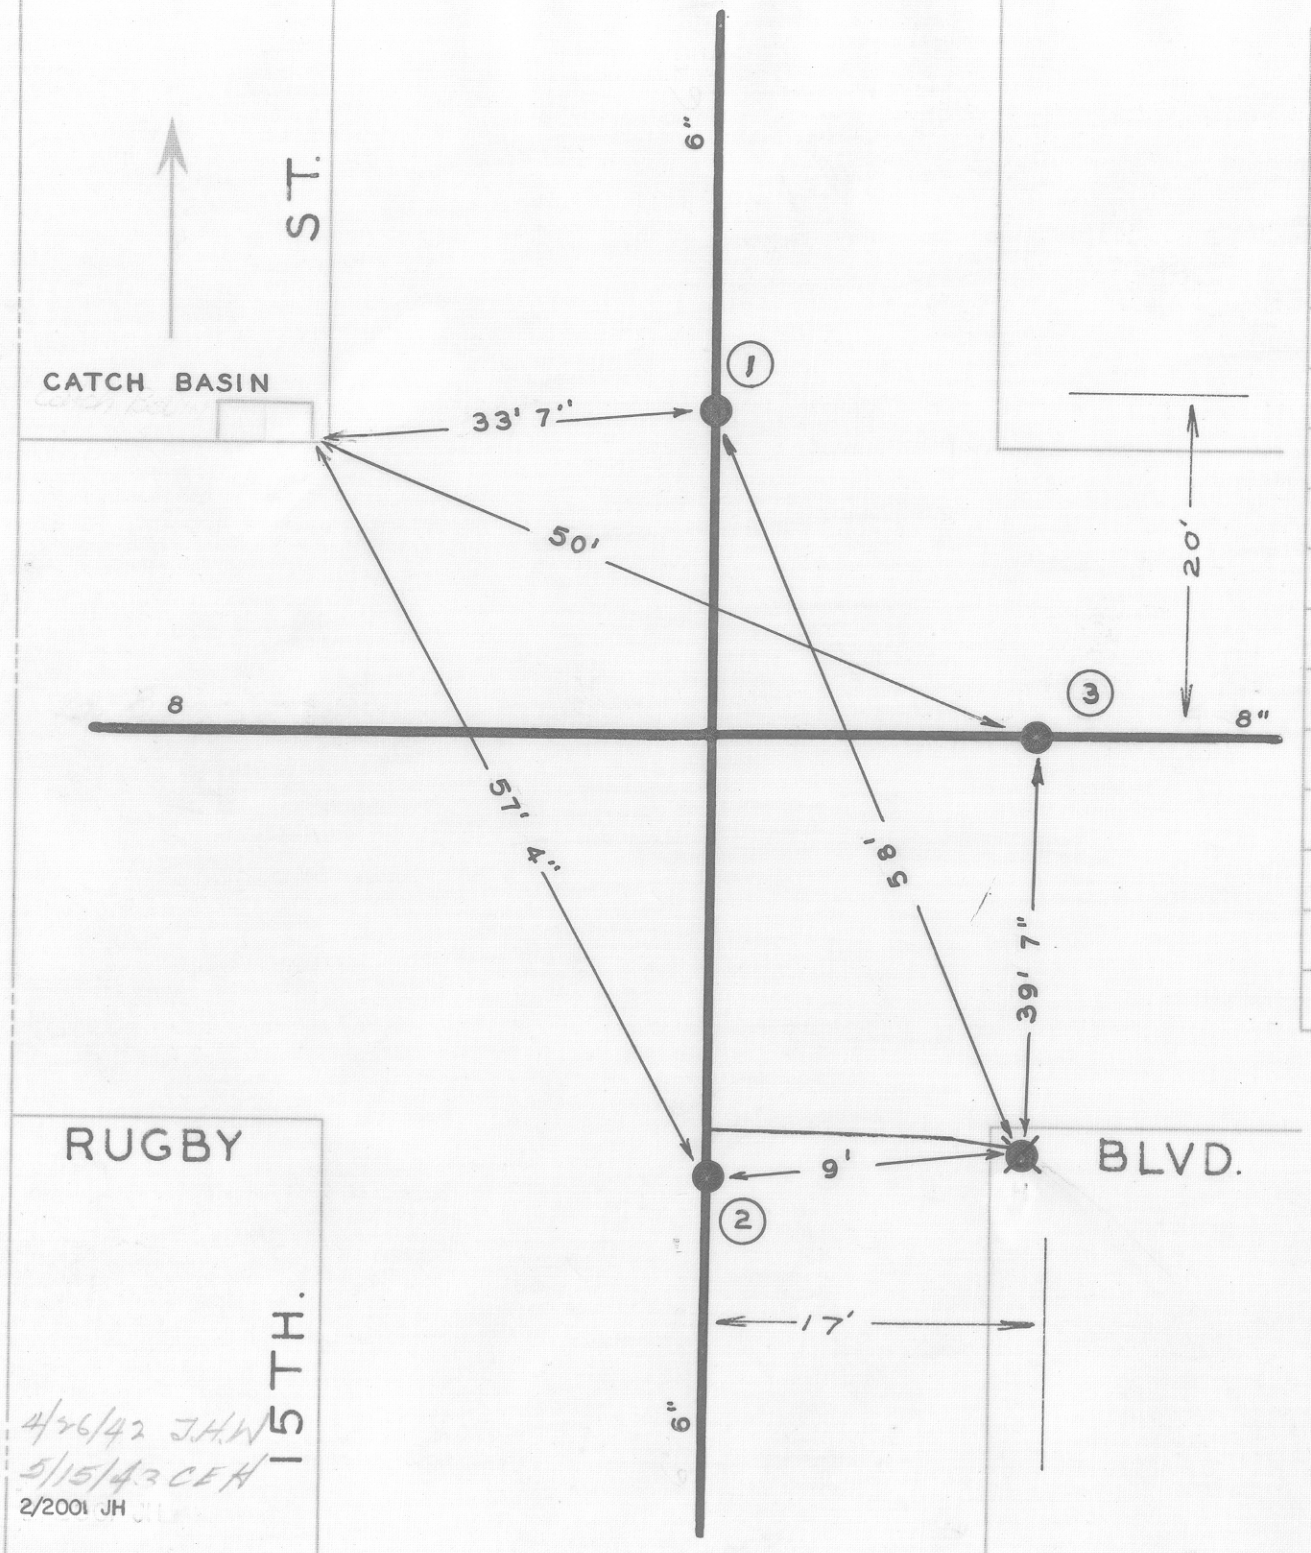

DATE	NO.	SIZE	MAKE	OPEN	TURNS
1939	1	6"		R	20
1939	2	6		R	20
1939	3	8"		R	27
	1	0	NPL		
	2	0	SPL		
	3	0	EPL		

CITY OF ROANOKE—WATER DEP'T

VALVE DIAGRAM

RUGBY BLVD. & 15TH. STREET

SEC. MAP 223 N.W.

DATE PAGE NO. NW 174