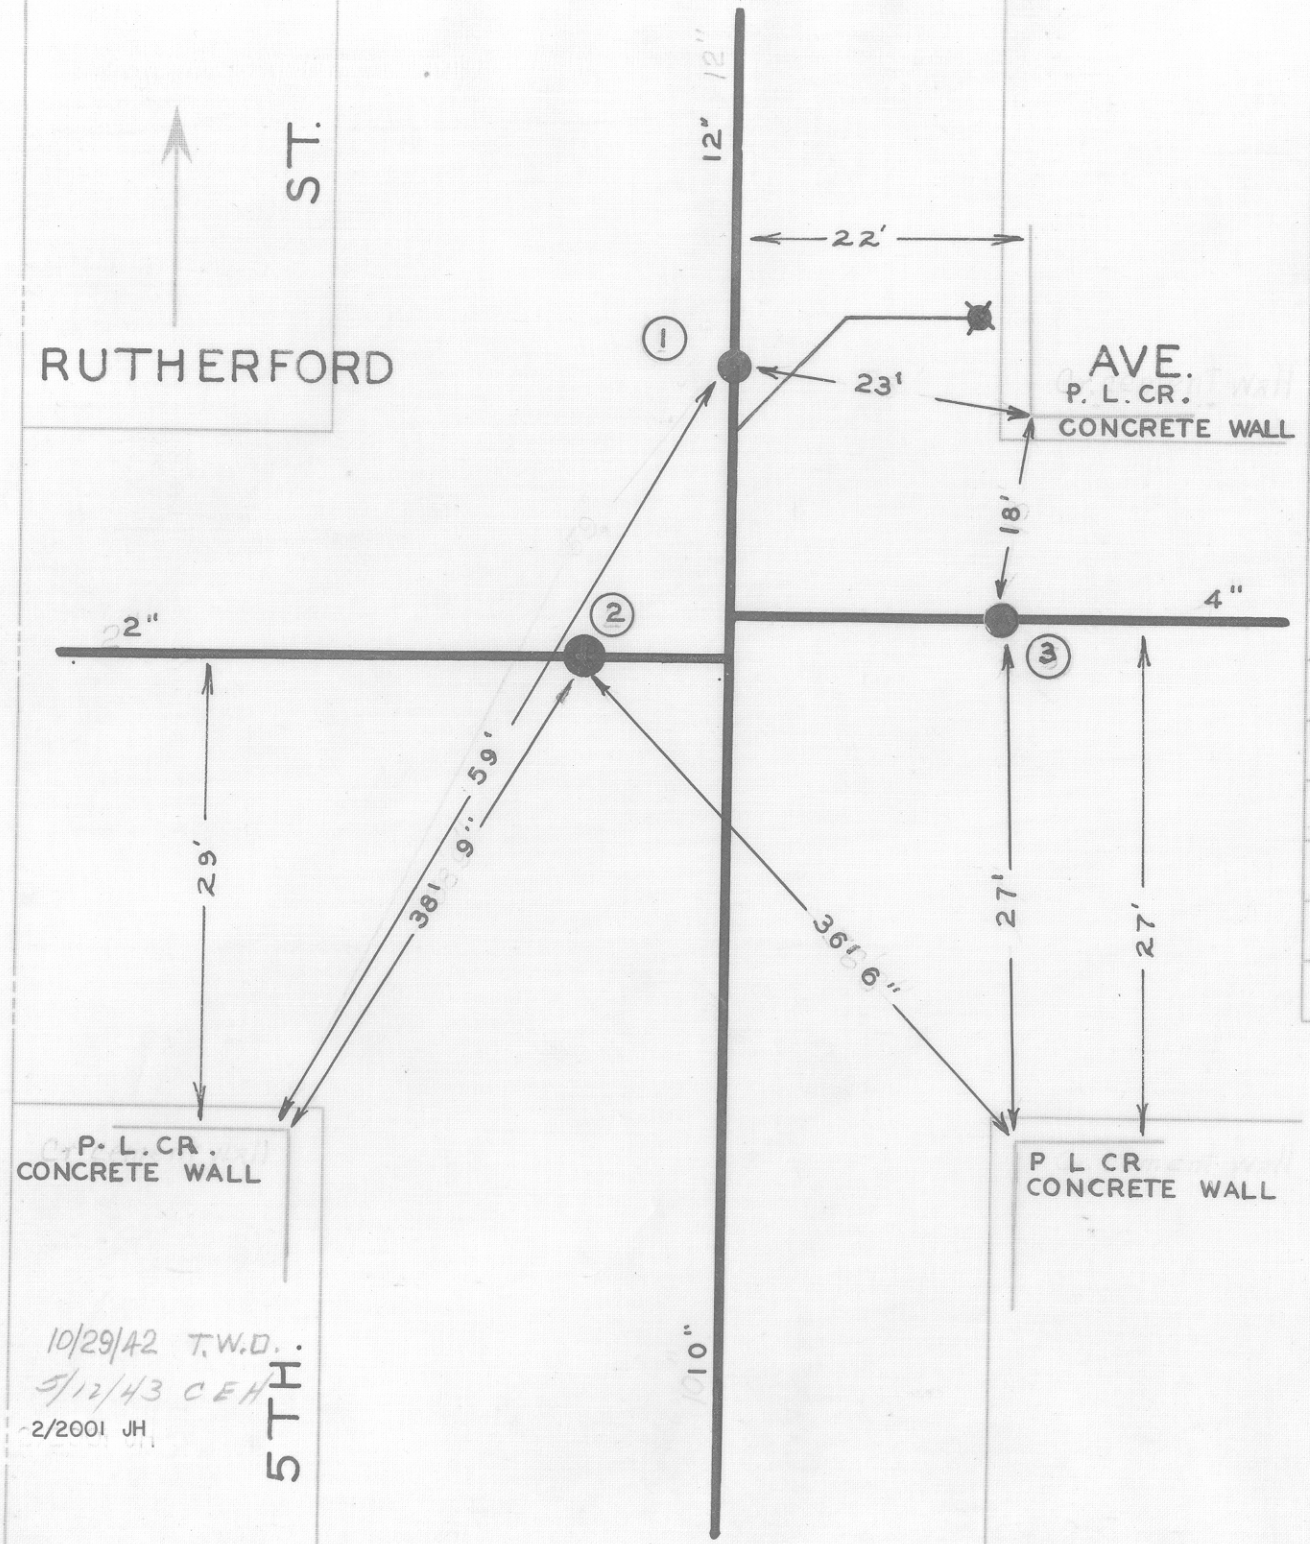

DATE	NO.	SIZE	MAKE	OPEN	TURNS
1925	1	12"		R	34 1/2
1926	2	2"		R	6
1906	3	4"		R	8 1/2
	1	8'-N	NPL		
	2	23'-W	EPL		
	3	3'-W	EPL		

CITY OF ROANOKE—WATER DEP'T

VALVE DIAGRAM

RUTHERFORD AVE. & 5TH. ST. N.W.

SEC. MAP 202 N. W.

DATE PAGE NO. NW 37