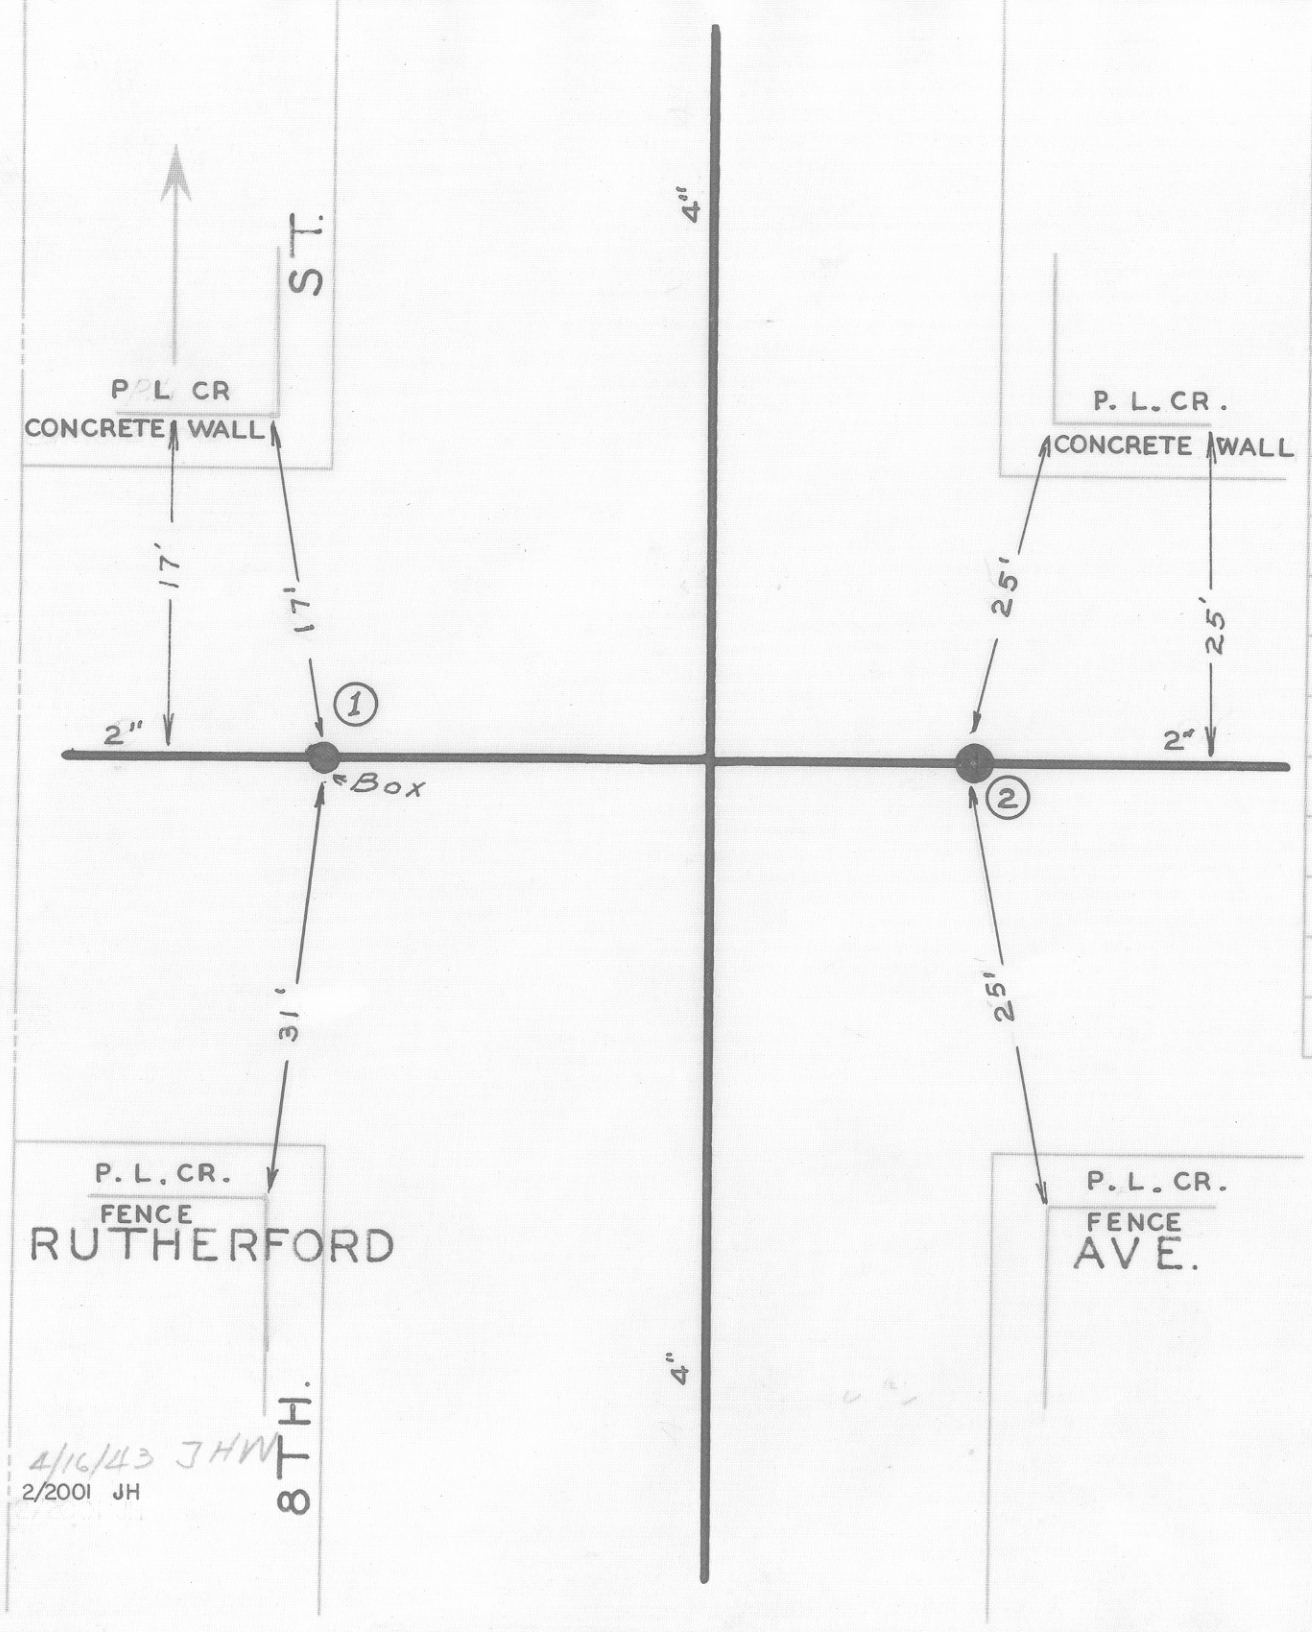

DATE	NO.	SIZE	MAKE	OPEN	TURNS
1927	1	2"		R	8
1905	2	2"		R	7
	1	0	WPL		
	2	7'-W	EPL		

4/16/43 JHW
2/2001 JH

CITY OF ROANOKE—WATER DEP'T
VALVE DIAGRAM
RUTHERFORD AVE. &
8TH. ST. N.W.

SEC. MAP 212 N. W.
DATE PAGE NO. N.W. 105