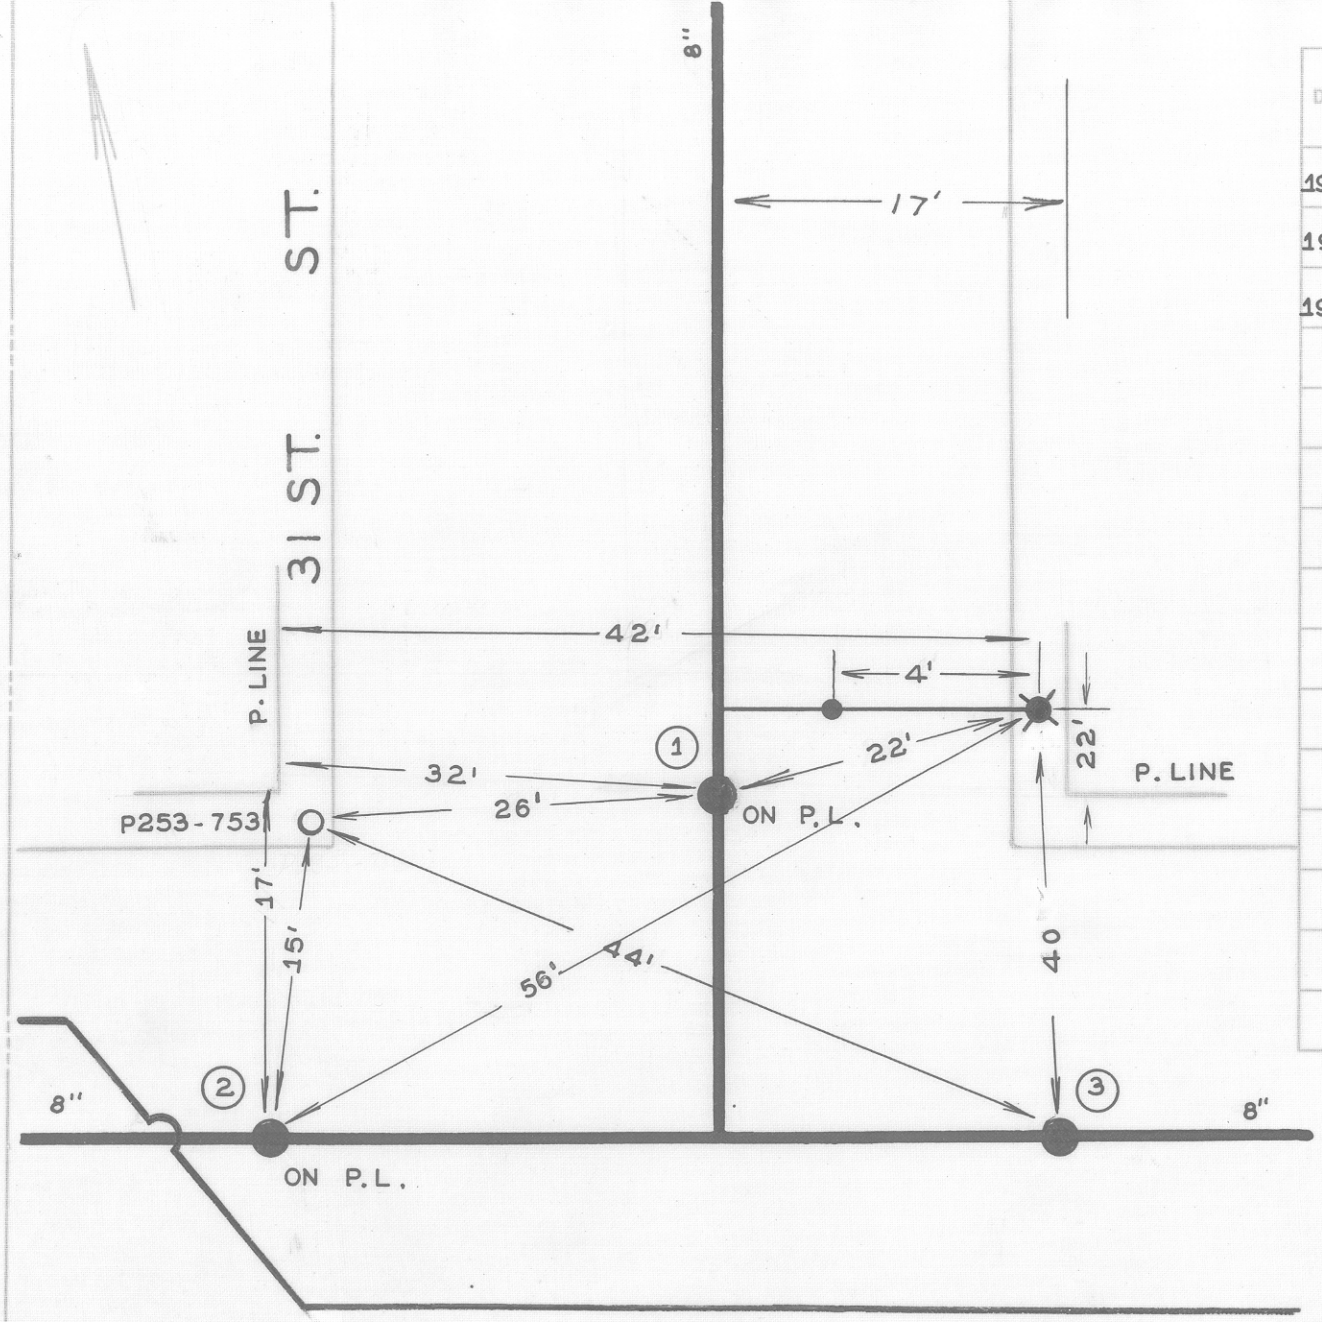

DATE	NO.	SIZE	MAKE	OPEN	TURNS
1950	1	8"	DARLING	R	26 1/2
1950	2	8"	DARLING	R	26 1/2
1950	3	8"	DARLING	R	26 1/2
	1	0	NPL		
	2	0	WPL		
	3	0	EPL		

CITY OF ROANOKE—WATER DEP'T

VALVE DIAGRAM

SALEM TURNPIKE &

31 ST. STREET N.W.

SEC. MAP 253, 252 N.W.

DATE PAGE NO. N.W.352

3/2001 JH

SALEM TURNPIKE