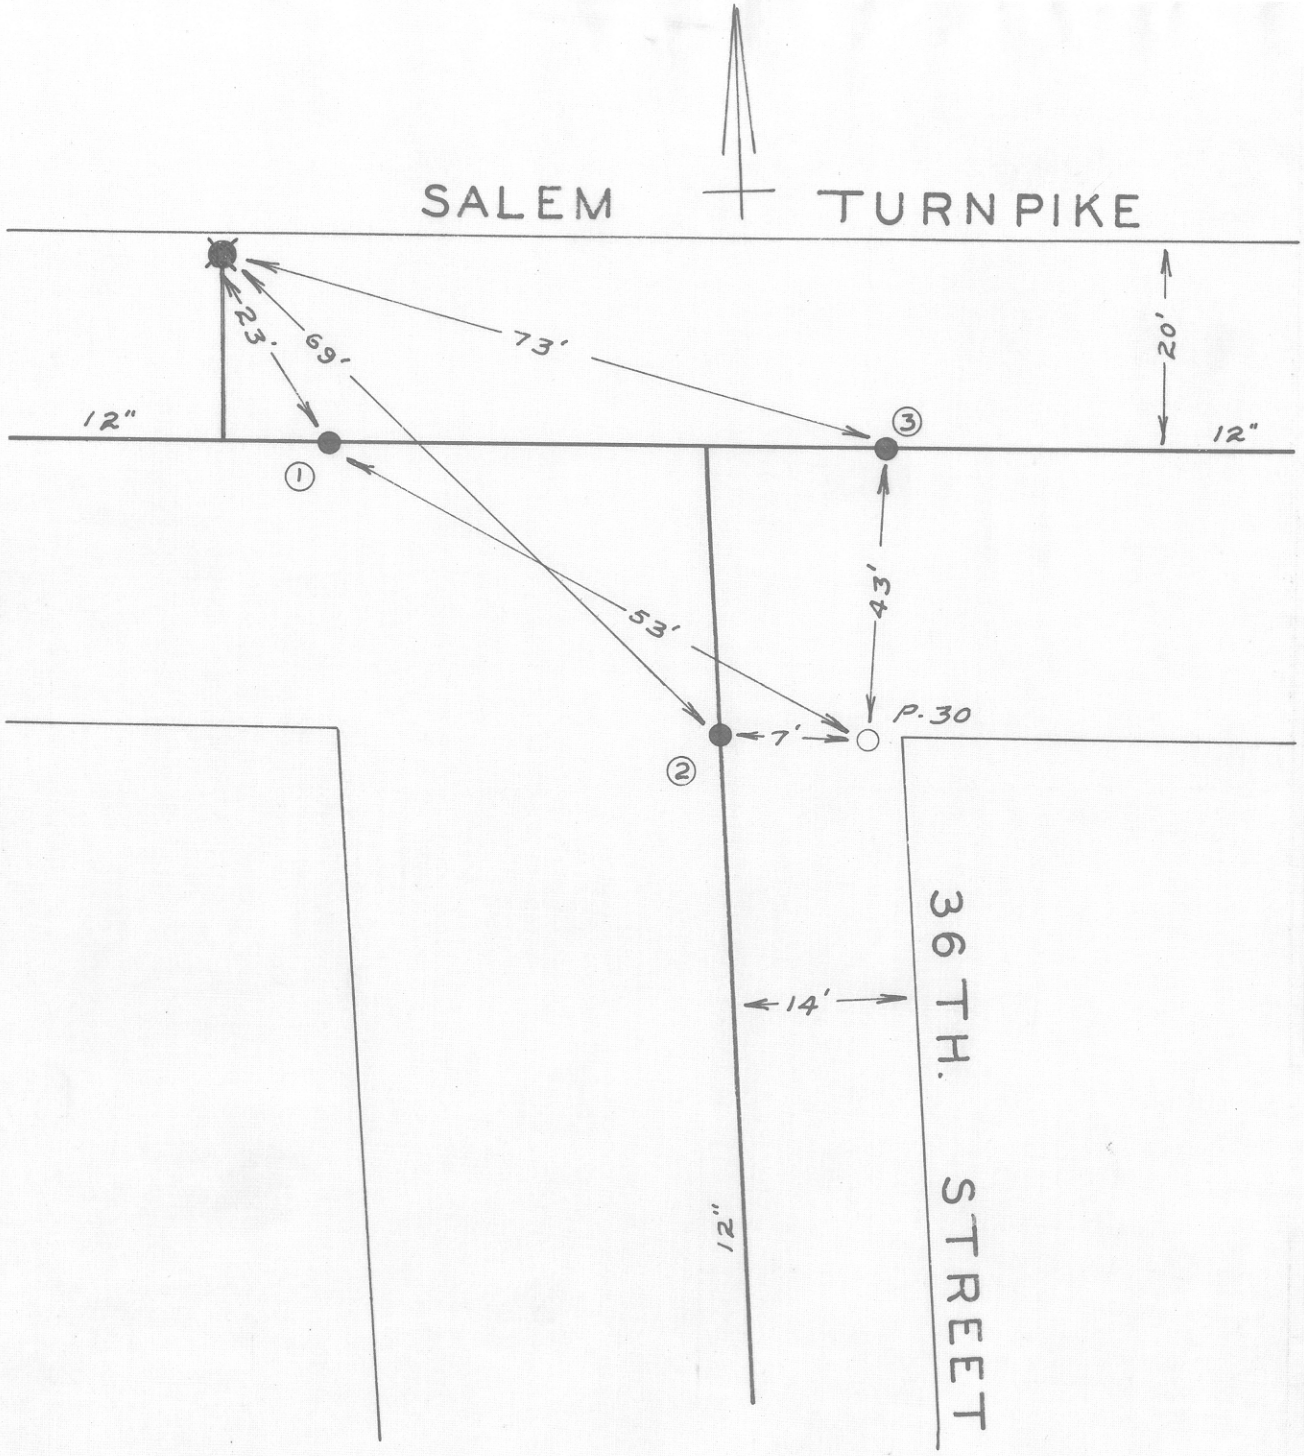

DATE	NO.	SIZE	MAKE	OPEN	TURNS
1952	1	12"	MUELLER	R	38
1952	2	12"	MUELLER	R	38
1952	3	12"	MUELLER	R	38
	1	0	WPL		
	2	0	SPL		
	3	0	EPL		

CITY OF ROANOKE—WATER DEPT.

VALVE DIAGRAM

SALEM TURNPIKE &

36TH. STREET

SEC. MAP 264 N.W.

DATE PAGE NO.

3/2001 JH

"IMPERIAL" TRACING CLOTH. K & E CO., N. Y.