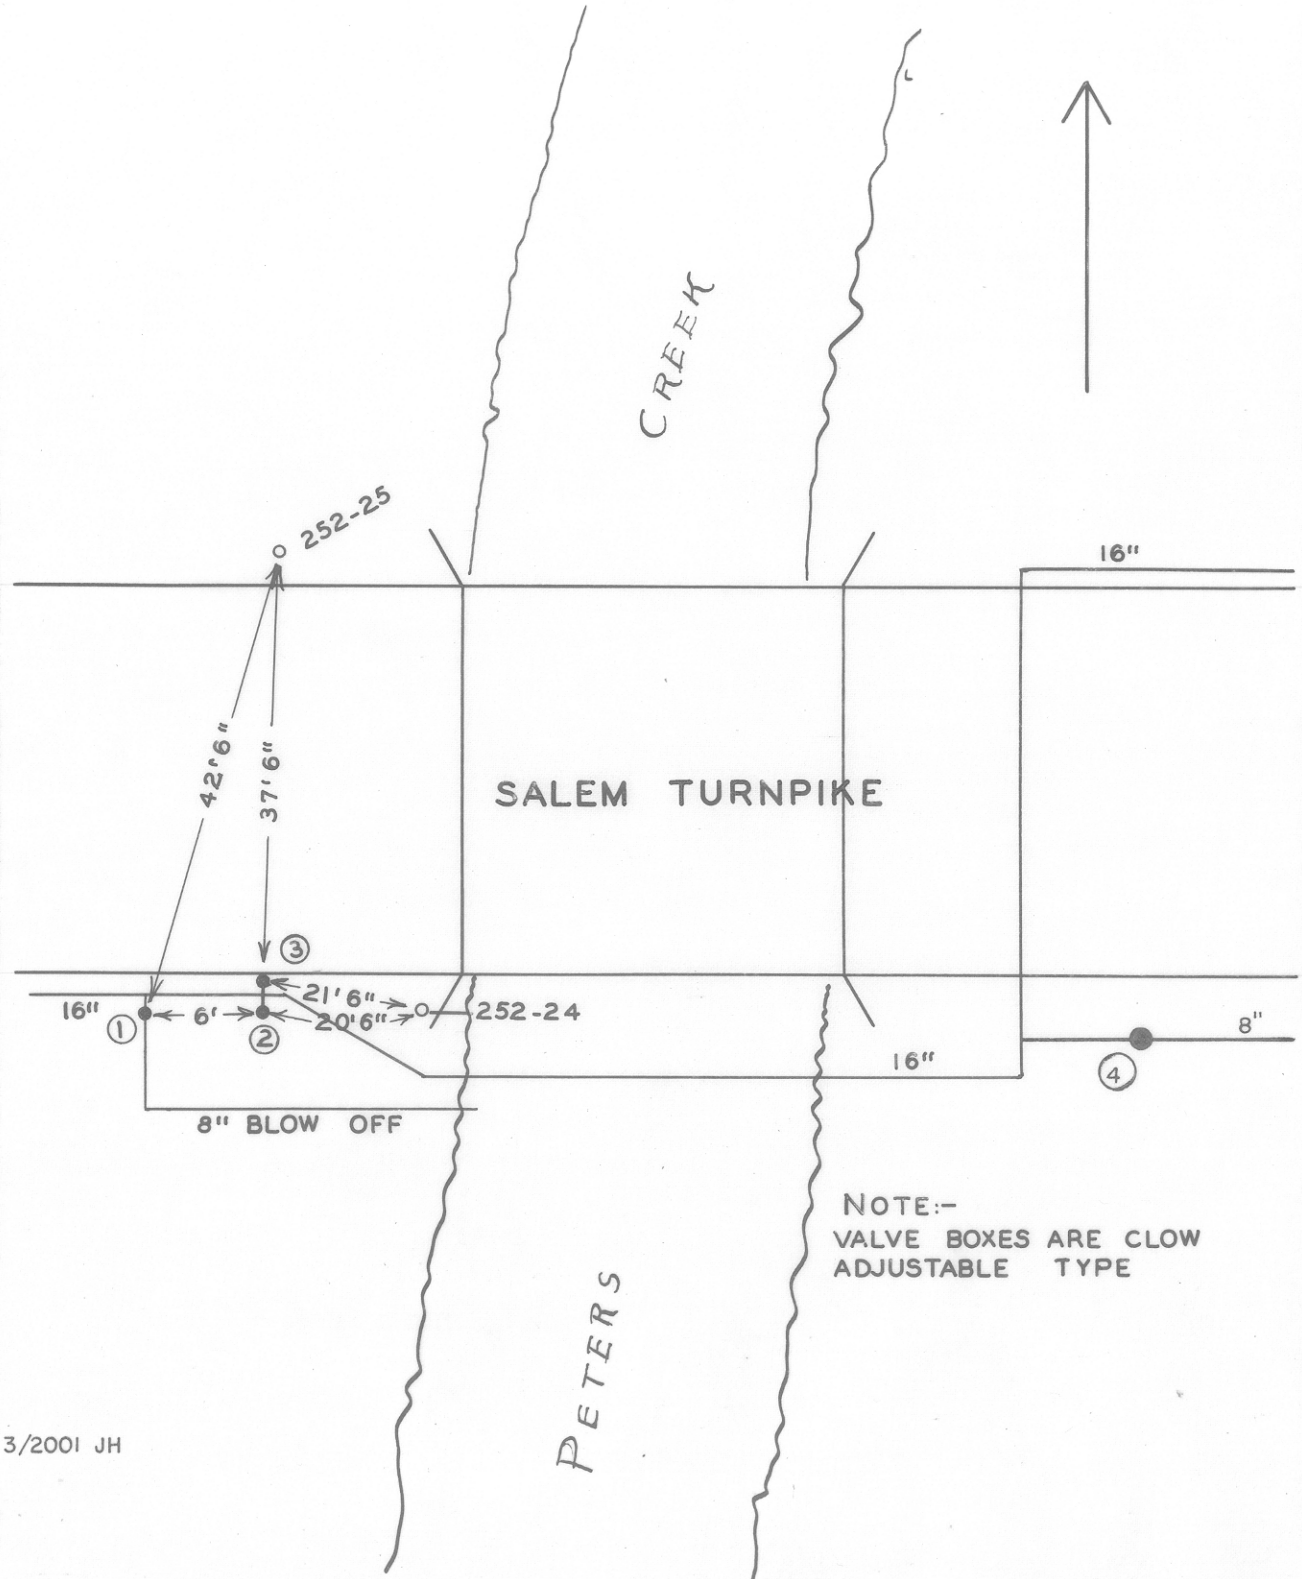

DATE	NO.	SIZE	MAKE	OPEN	TURNS
4-63	1	8"	DARLING	R	26½
4-63	2	16"	DARLING	R	105
1963	3	3	BY PASS	R	
1964	4	8"			

NOTE:-
VALVE BOXES ARE CLOW ADJUSTABLE TYPE

3/2001 JH

CITY OF ROANOKE — WATER DEPT.

VALVE DIAGRAM

SALEM TURNPIKE AT PETERS CREEK BRIDGE

SEC. MAP 274 N. W.

DATE PAGE NO.