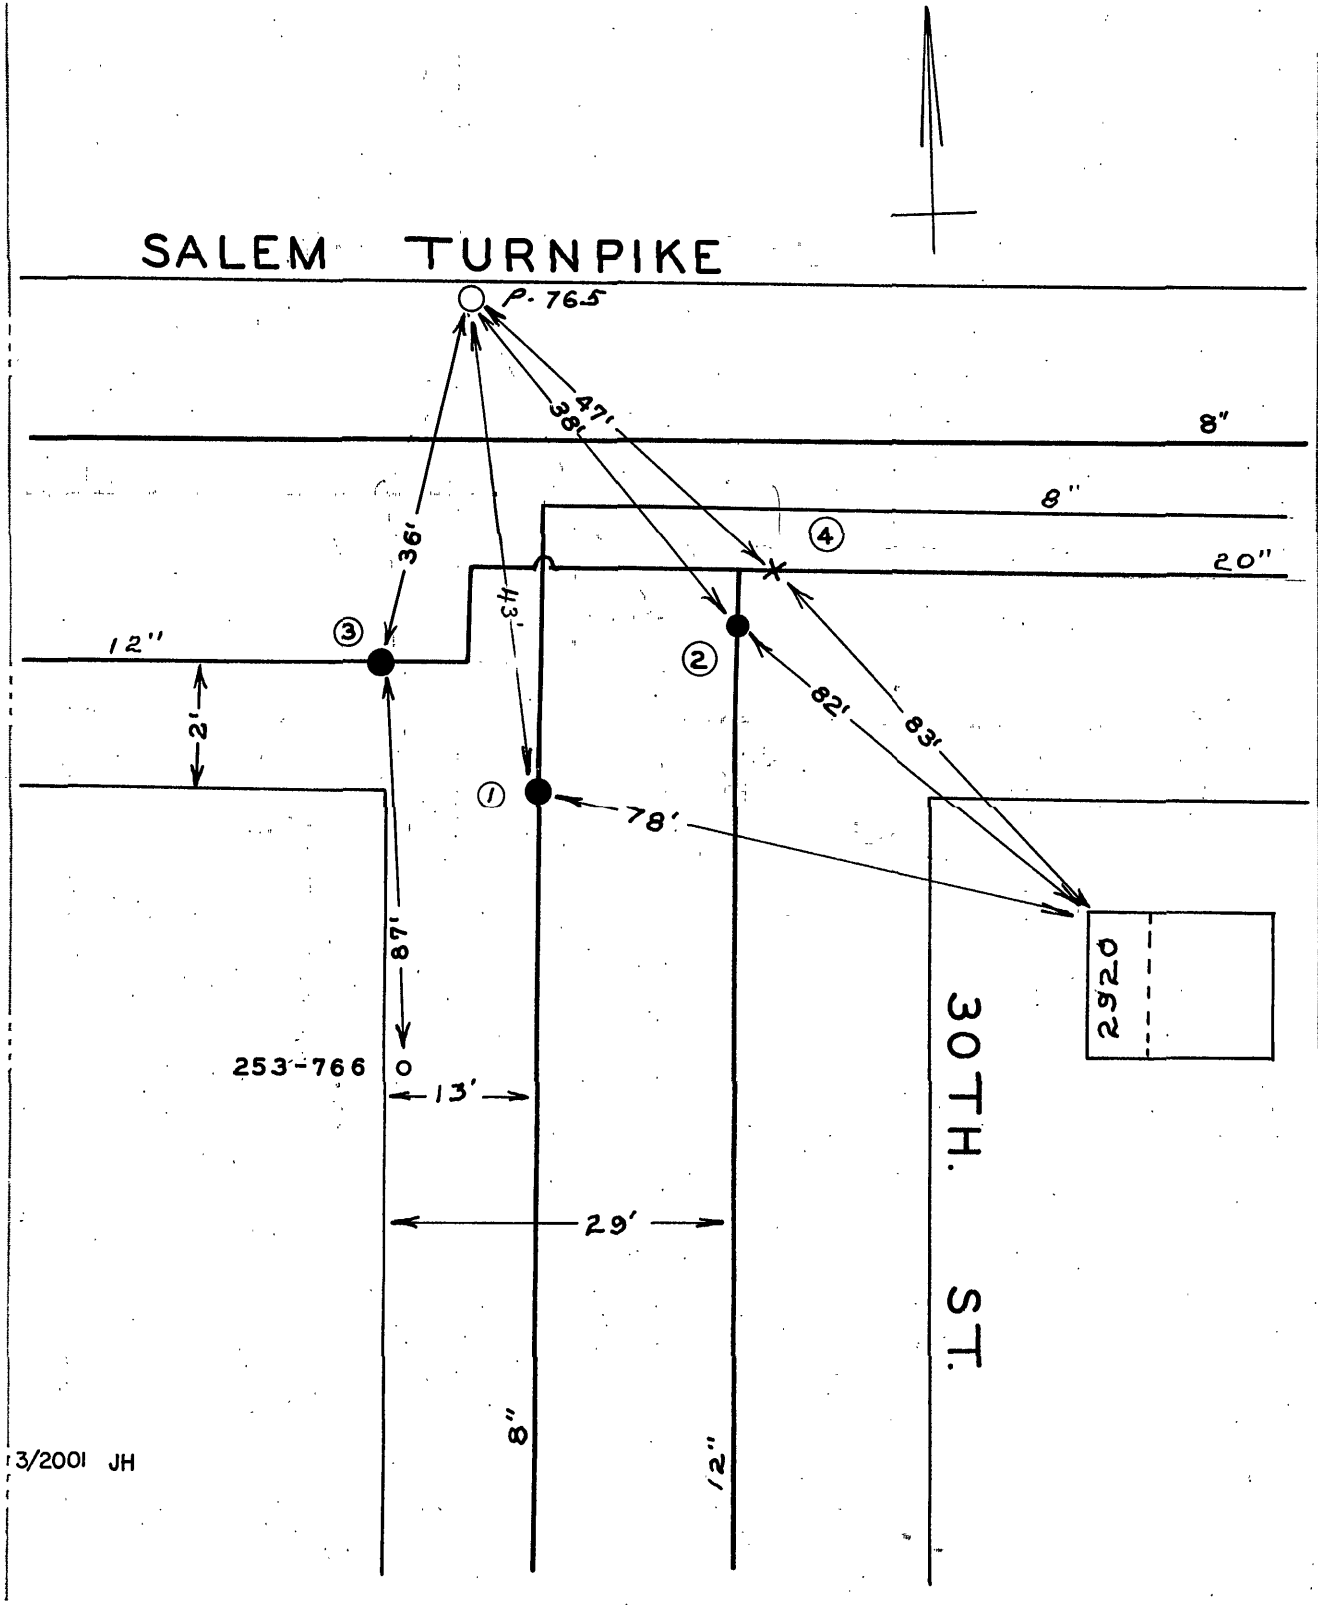

DATE	NO.	SIZE	MAKE	OPEN	TURNS
1952	1	8"	MUELLER	R	27
1964	2	12"	MUELLER	R	39
5-63	3	12"	MUELLER	R	39
12-64	4	1½"	AIR VALVE		
	1	13'-N	SPL		
	3	0	W.P.L.		

CITY OF ROANOKE—WATER DEPT.

VALVE DIAGRAM

SALEM TURNPIKE &

30 TH. ST.

EAST INTERSECTION

SEC. MAP 253 252 N.W.

DATE PAGE NO.

3/2001 JH

"IMPERIAL" TRACING CLOTH
K & E CO., N.Y.