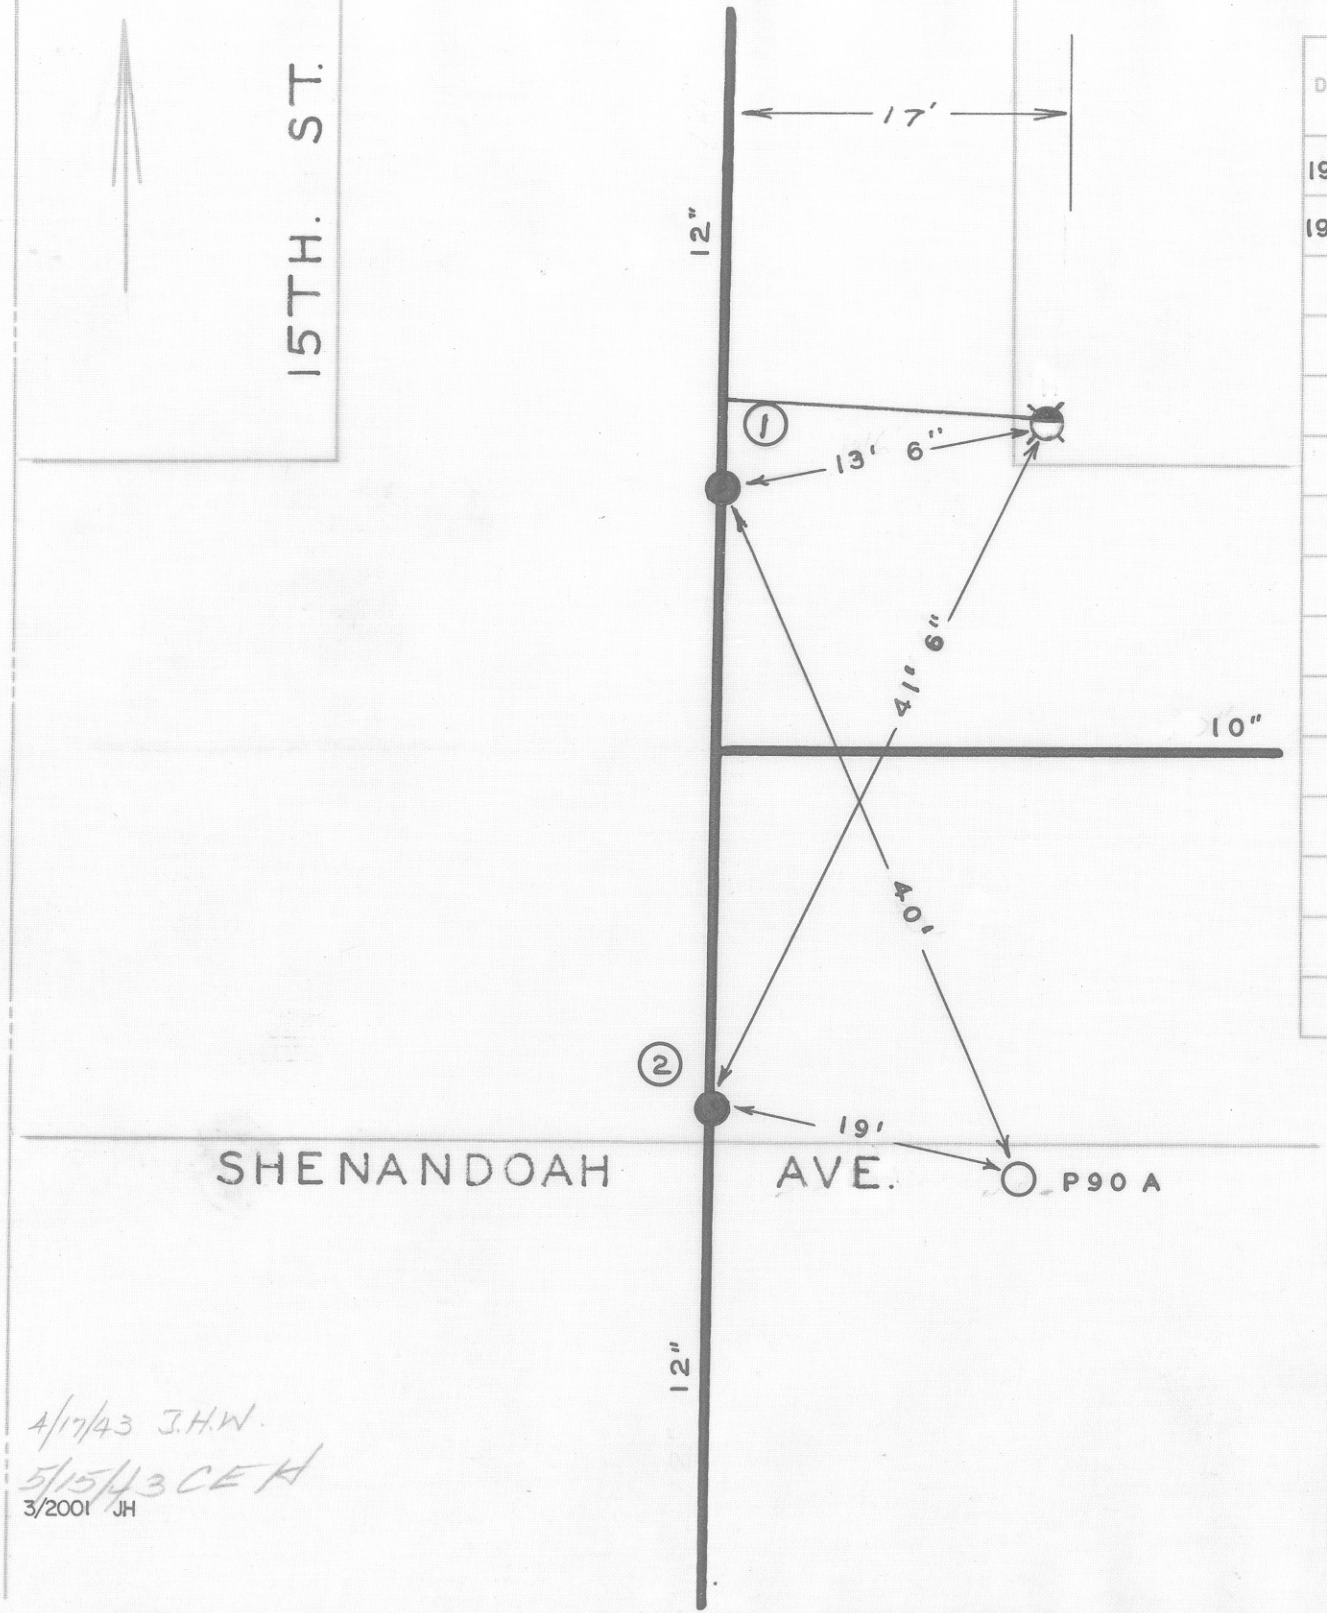

DATE	NO.	SIZE	MAKE	OPEN	TURNS
1923	1	12"		R	38
1942	2	12"		R	39
	1	12'-S	NPL		
	2	8'-N	SPL		

CITY OF ROANOKE—WATER DEP'T

VALVE DIAGRAM

SHENANDOAH AVE &

15T. ST.

SEC. MAP 221 N.W.

DATE PAGE NO. N.W. 115

4/17/43 J.H.W.

5/15/43 CEH

3/2001 JH