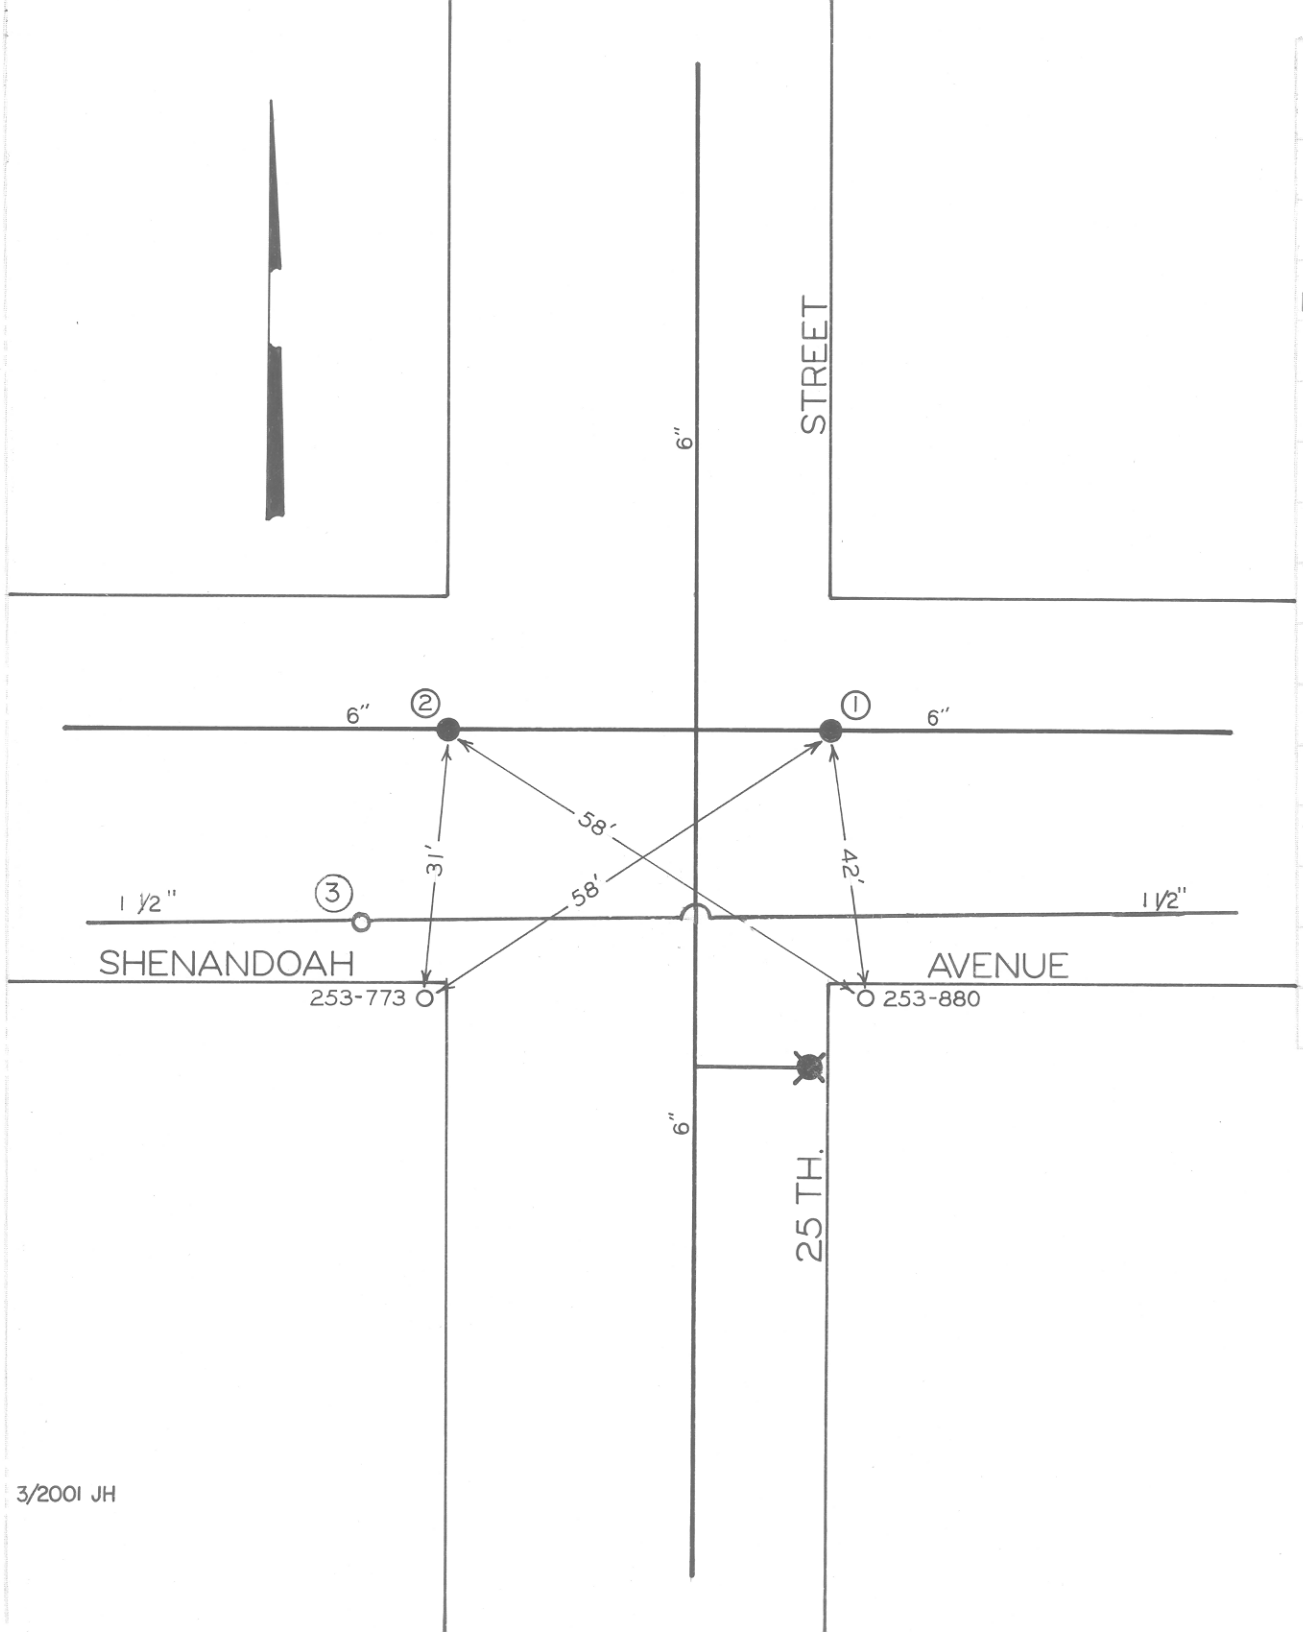

DATE	NO.	SIZE	MARK	OPEN	TURNS
74	1	6"	MUELLER	R	
74	2	6"	MUELLER	R	
1923	3	1 1/2"			

3/2001 JH

CITY OF ROANOKE—WATER DEP'T

VALVE DIAGRAM

SHENANDOAH AVENUE &
25 TH. STREET

SEC. MAP 241, 231, 242 N.W.

DATE PAGE NO.