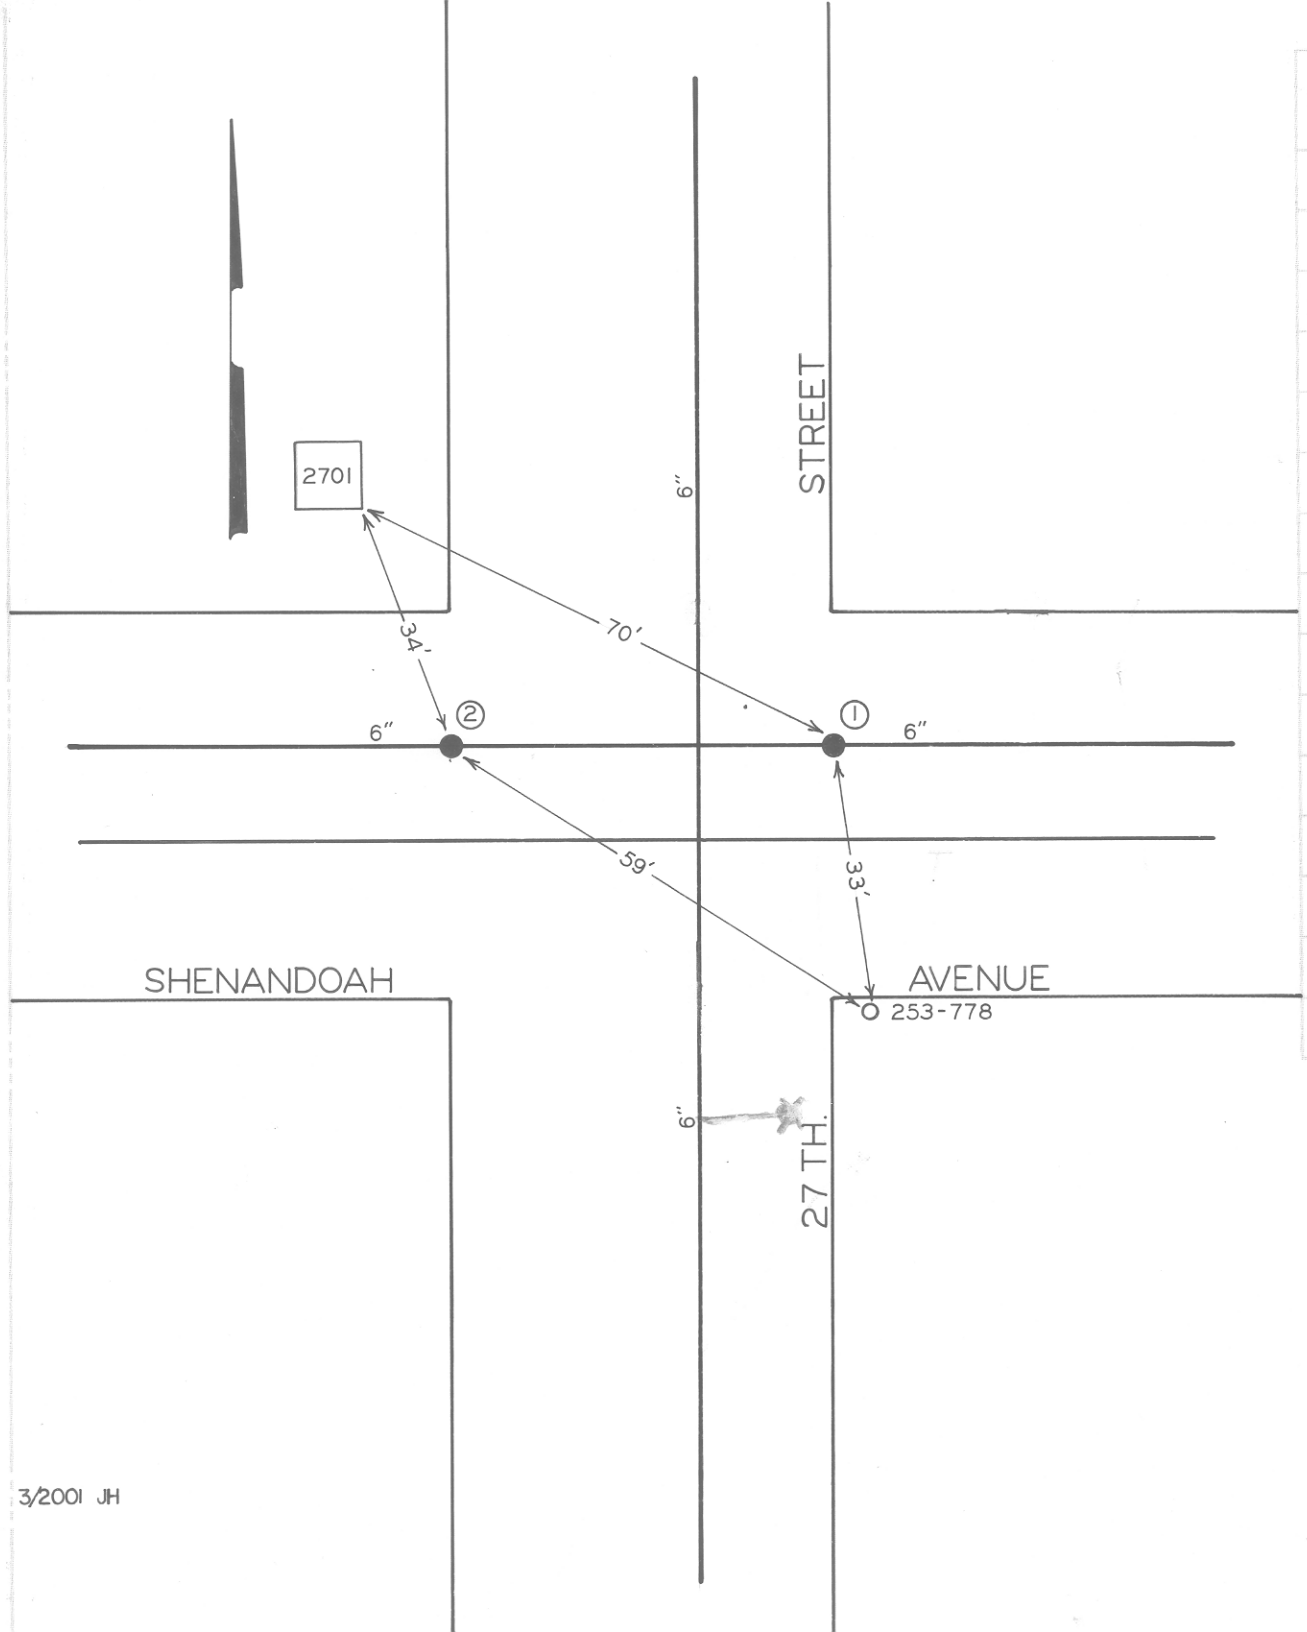

DATE	NO.	SIZE	MAKE	OPEN	TURNS
74	1	6"	MUELLER	R	
74	2	6"	MUELLER	R	

3/2001 JH

CITY OF ROANOKE—WATER DEP'T

VALVE DIAGRAM

SHENANDOAH AVENUE &
27 TH. STREET

SEC. MAP 241, 242 N.W.

DATE PAGE NO.