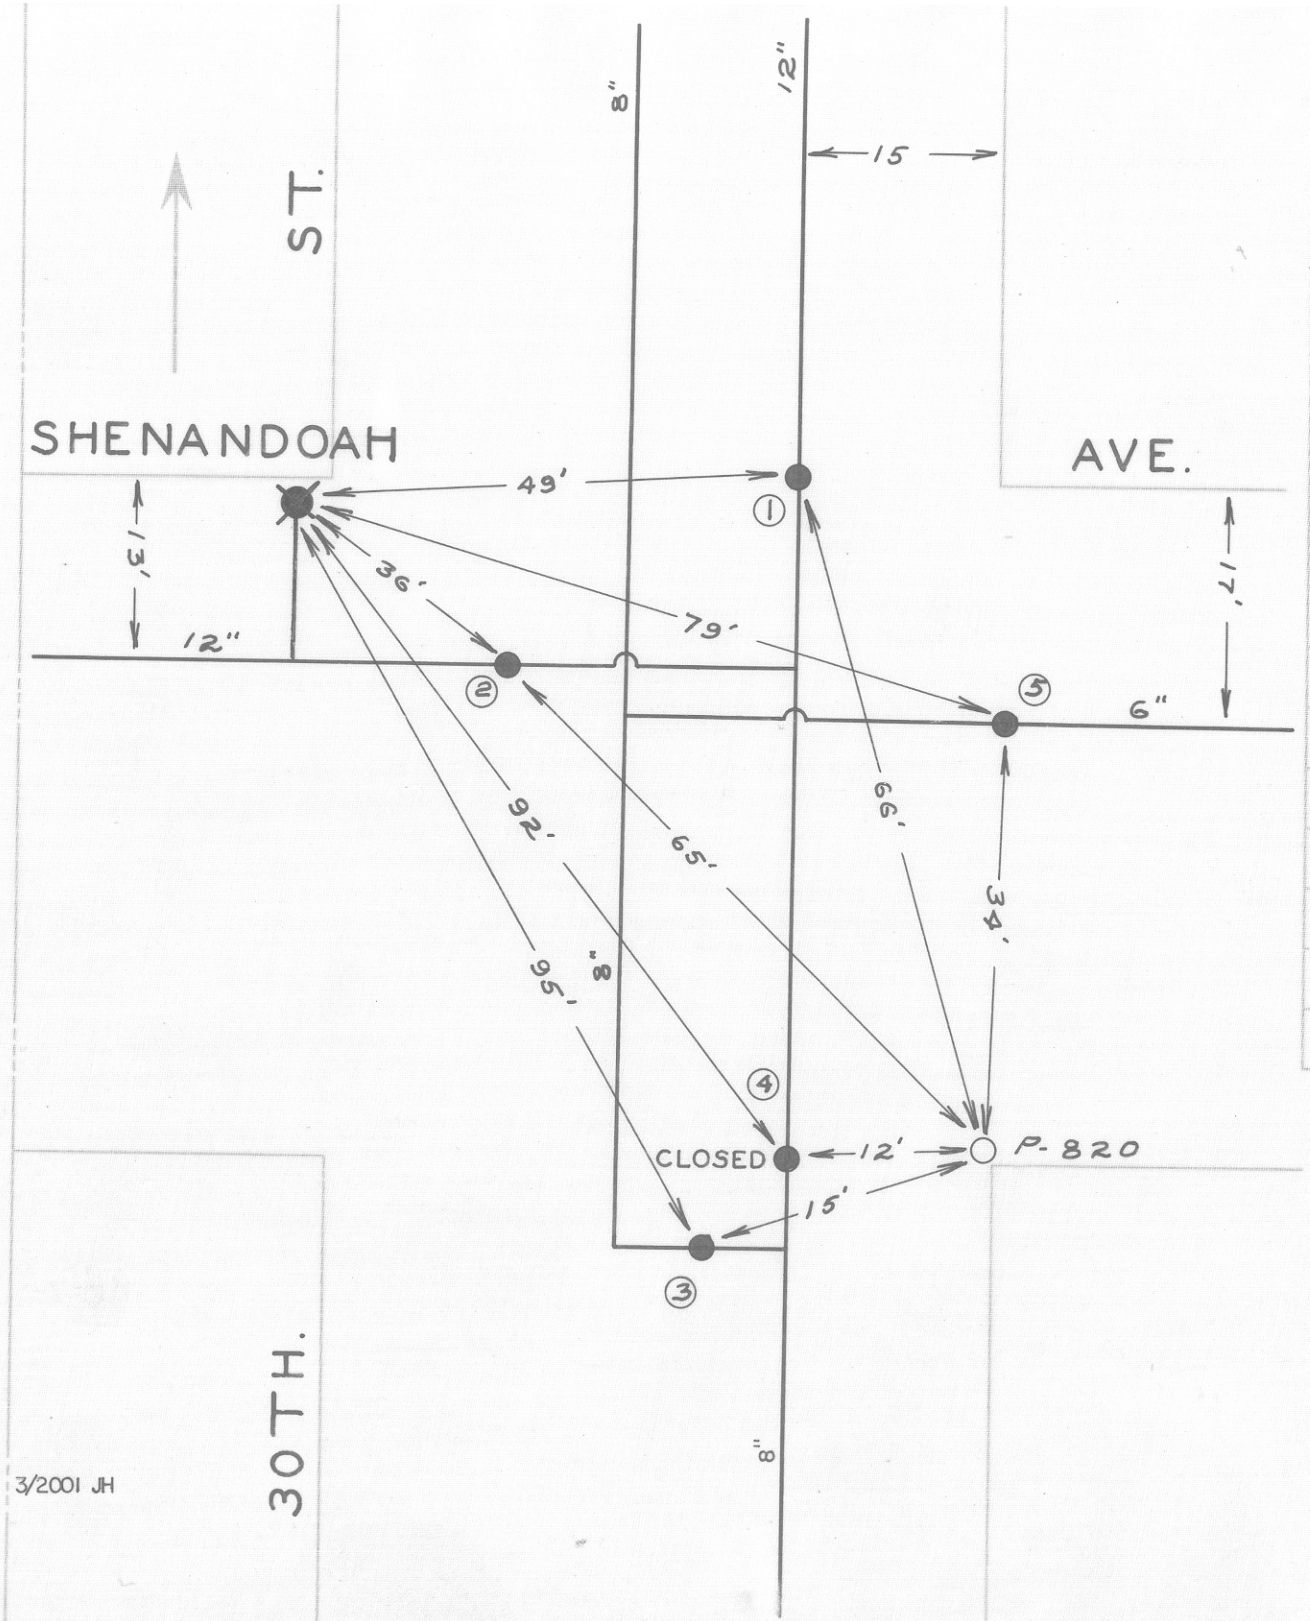

DATE	NO.	SIZE	MAKE	OPEN	TURNS
1951 ~~1952~~	1	12"	DARLING	R	38
1951 ~~1952~~	2	12"	DARLING	R	38
1951 ~~1952~~	3	8"	MUELLER	R	27
1951	4	8"	DARLING	R	27
1952	5	6"	DARLING	R	20
	1	0	NPL		
	2	35'-E	WPL		
	3	9'-S	SPL		
	4	0	SPL		
	5	0	EPL		

CITY OF ROANOKE—WATER DEP'T

VALVE DIAGRAM

SHENANDOAH AVE. &

30TH. ST.

SEC. MAP 252 N.W.

DATE PAGE NO.

3/2001 JH