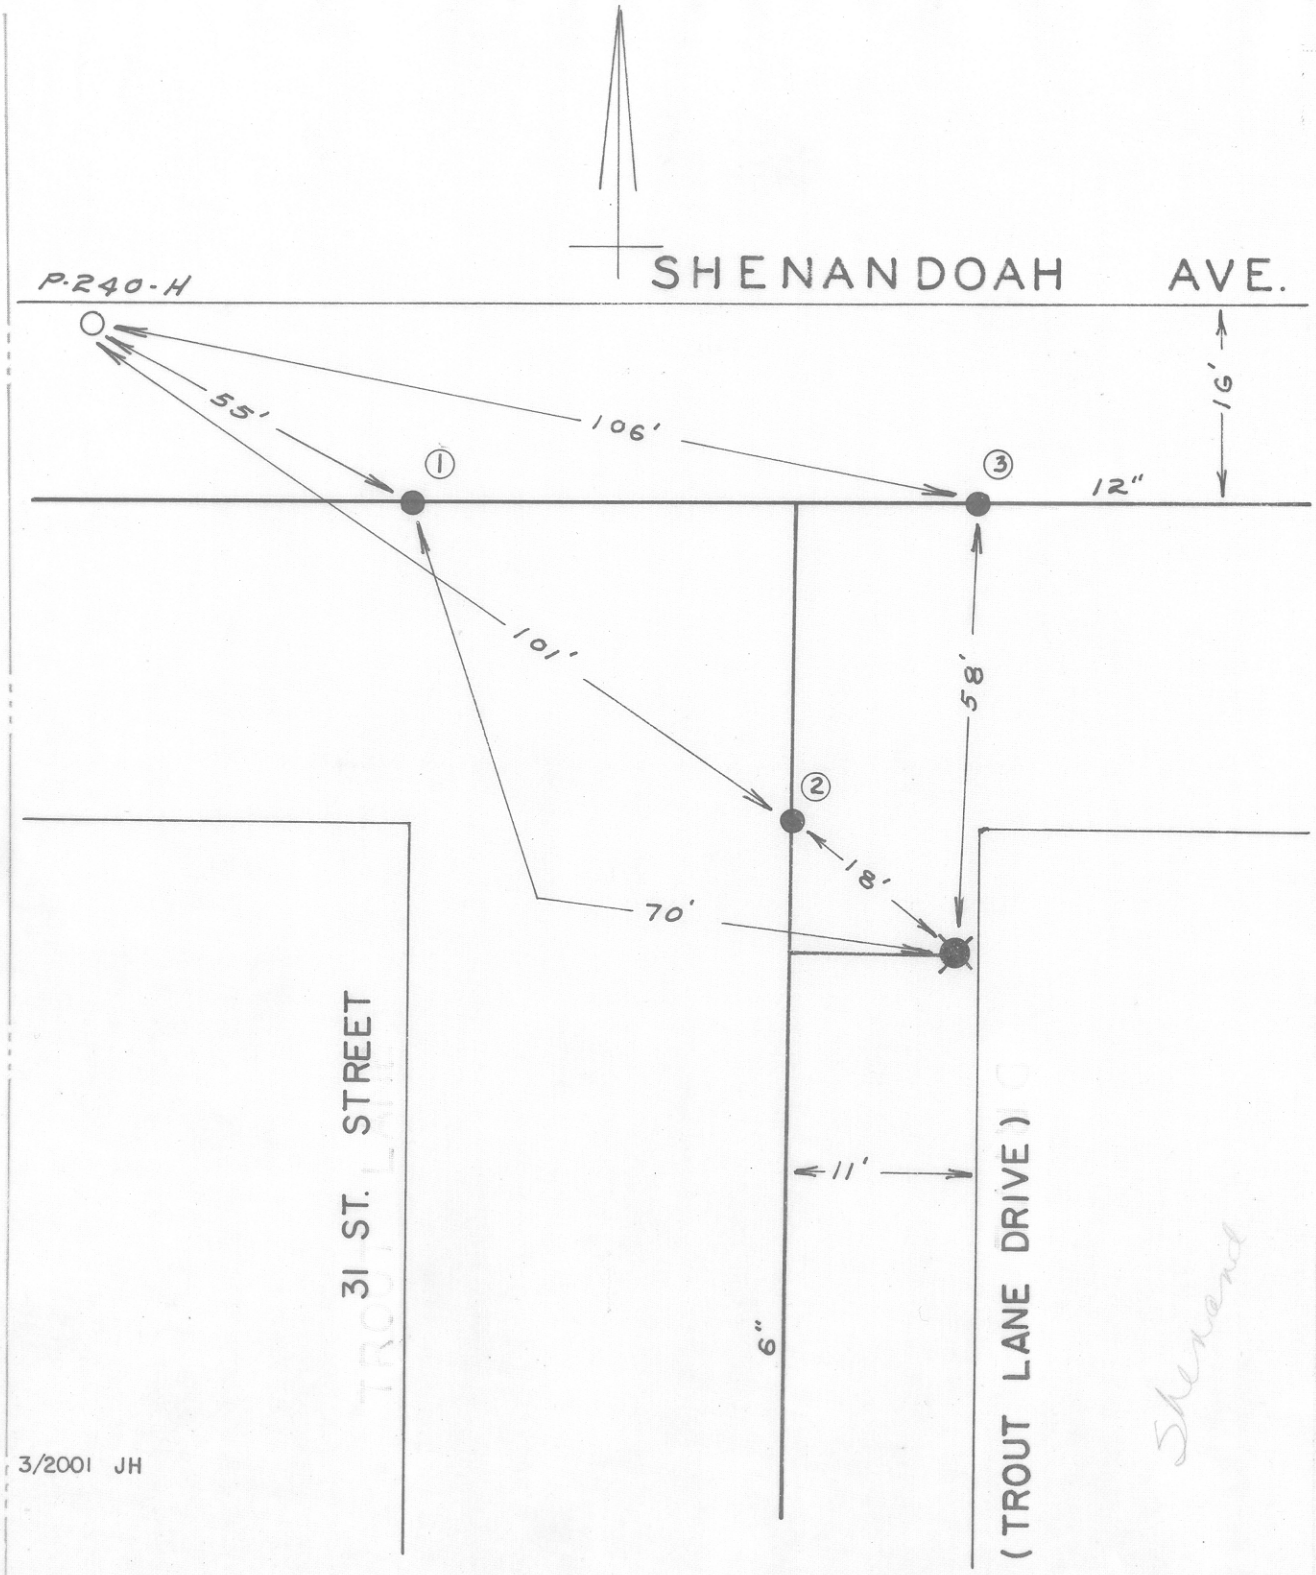

DATE	NO.	SIZE	MAKE	OPEN	TURNS
1952	1	12"	MUELLER	R	38
1952	2	6"	MUELLER	R	20
1952	3	12"	MUELLER	R	38
	1	0	WPL		
	2	0	SPL		
	3	0	EPL		

CITY OF ROANOKE — WATER DEPT.

VALVE DIAGRAM

SHENADOAH AVE. &

31 ST. STREET

SEC. MAP 251 N.W.

DATE PAGE NO.

Shenand

"IMPERIAL" TRACING CLOTH. K&E CO., N.Y.