DATE	NO.	SIZE	MAKE	OPEN	TURNS
1941	1	8"		R	27
1889	2	4"		R	15
	1	515'-E	EPL	4TH.	ST.
	2	524'-E	EPL	4TH.	ST.

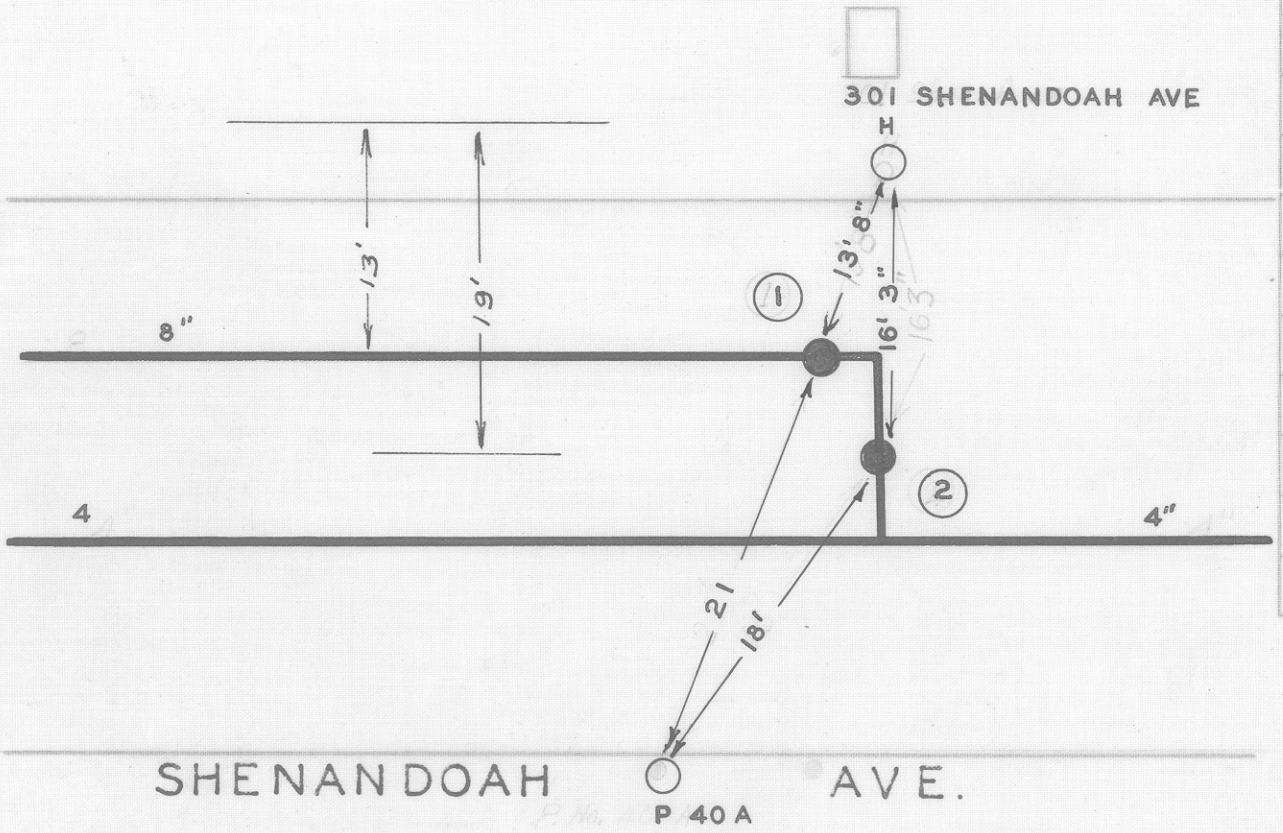

10/10/42 T.W.D.

CEH

CITY OF ROANOKE—WATER DEP'T
VALVE DIAGRAM

SHENANDOAH AVE. &
3RD. ST. N.W.

SEC. MAP 201

DATE PAGE NO. N.W. 4