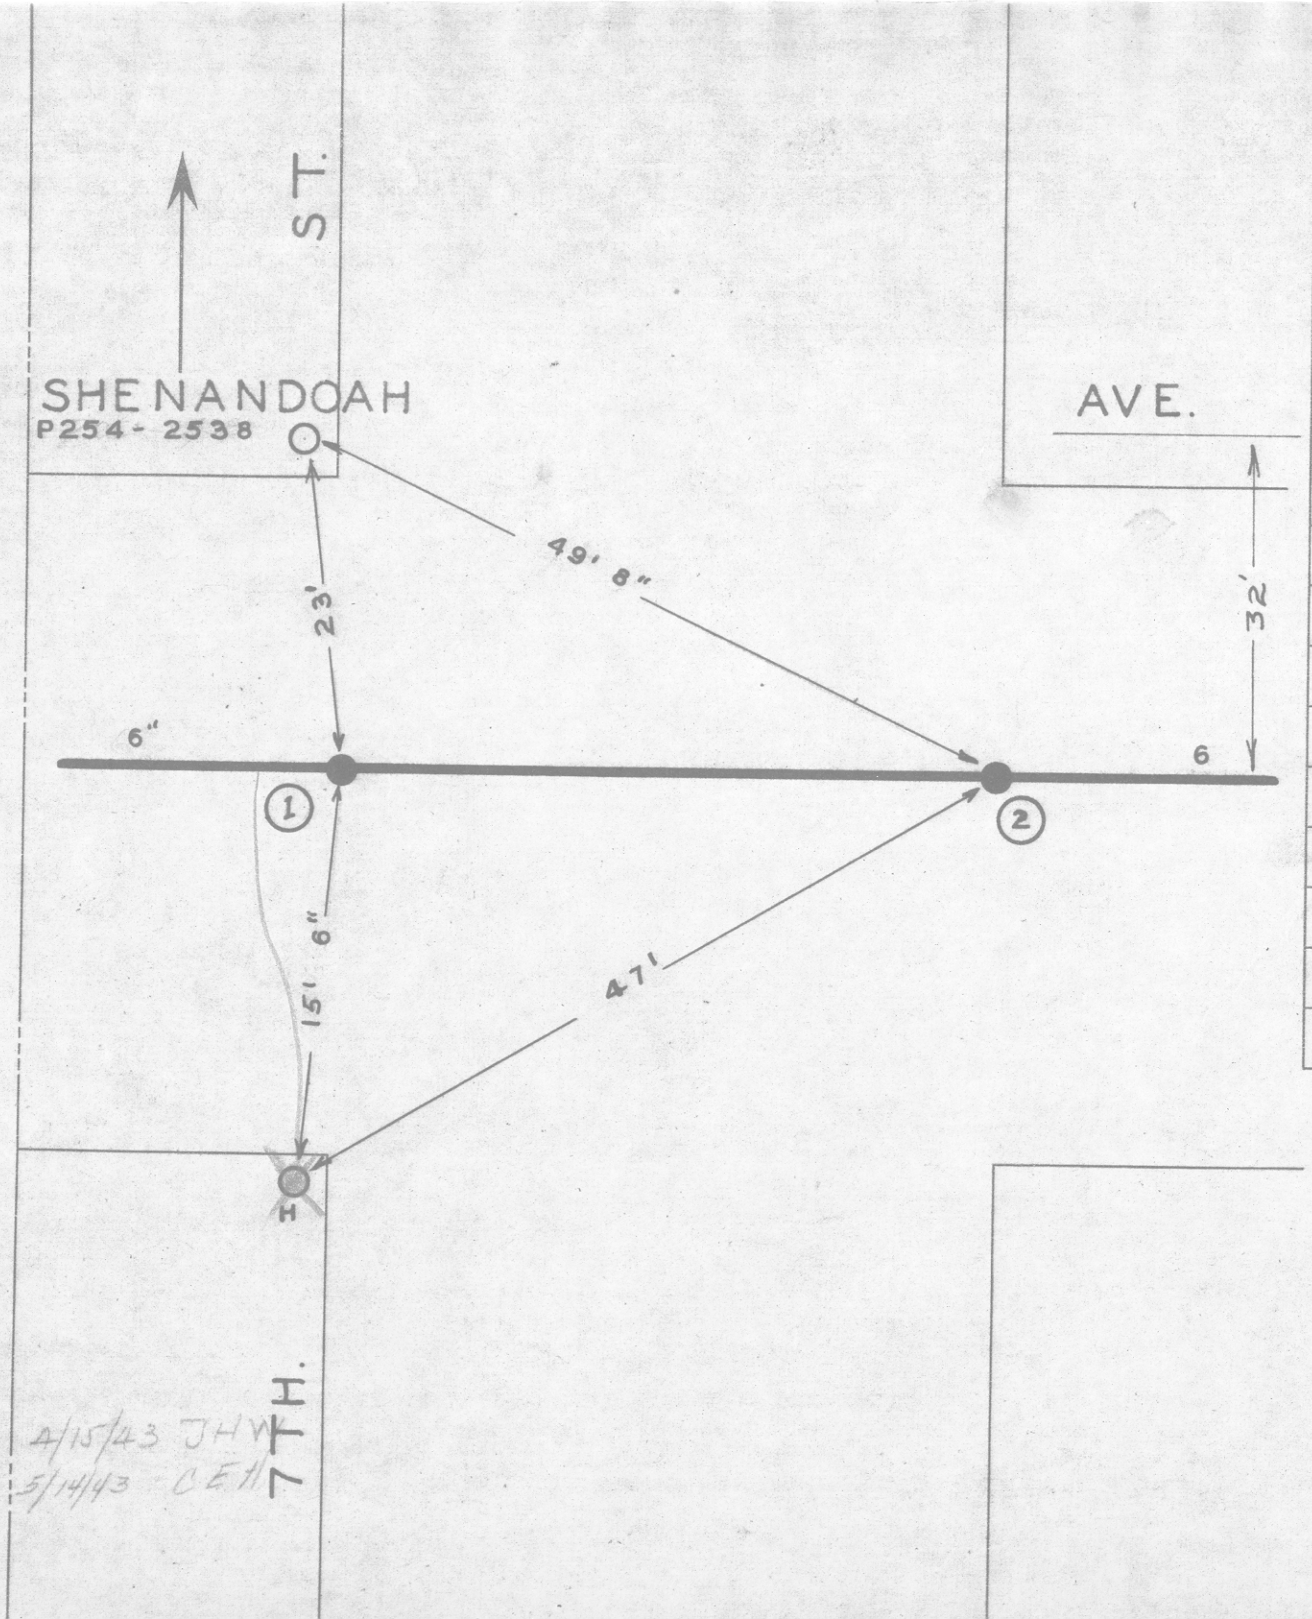

DATE	NO.	SIZE	MAKE	OPEN	TURNS
1893	1	6"		R	18
1893	2	6"		R	19 1/2
	1	6'-E	WPL		
	2	8'-W	EPL		

CITY OF ROANOKE—WATER DEP'T

VALVE DIAGRAM

SHENANDOAH AVE. & 7TH. ST. N. W.

SEC. MAP 211

DATE

PAGE NO. N.W. 81.