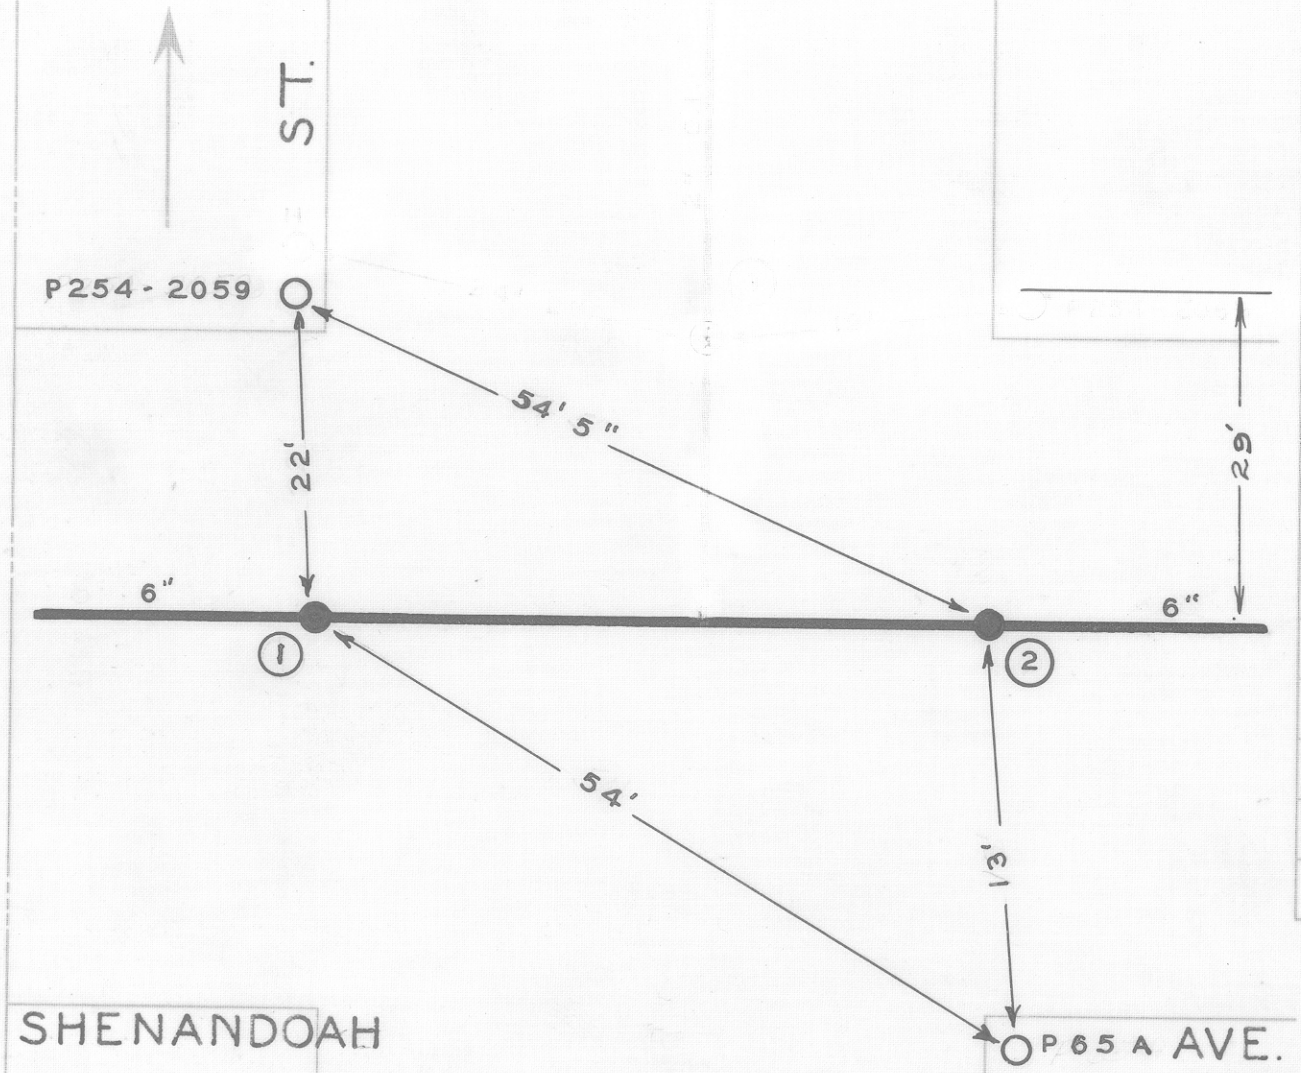

DATE	NO.	SIZE	MAKE	OPEN	TURNS
1891	1	6"		R	20
1891	2	6"		R	21
1946	3	2"	DARLING	R	7
	1	0	WPL		
	2	0	EPL		

4/15/43 J.H.W.
5/14/43 CEH
3/2001 JH

CITY OF ROANOKE—WATER DEP'T
VALVE DIAGRAM
SHENANDOAH AVE. &
9TH. ST. N.W.

SEC. MAP 211 N.W.
DATE PAGE NO. N.W. 82