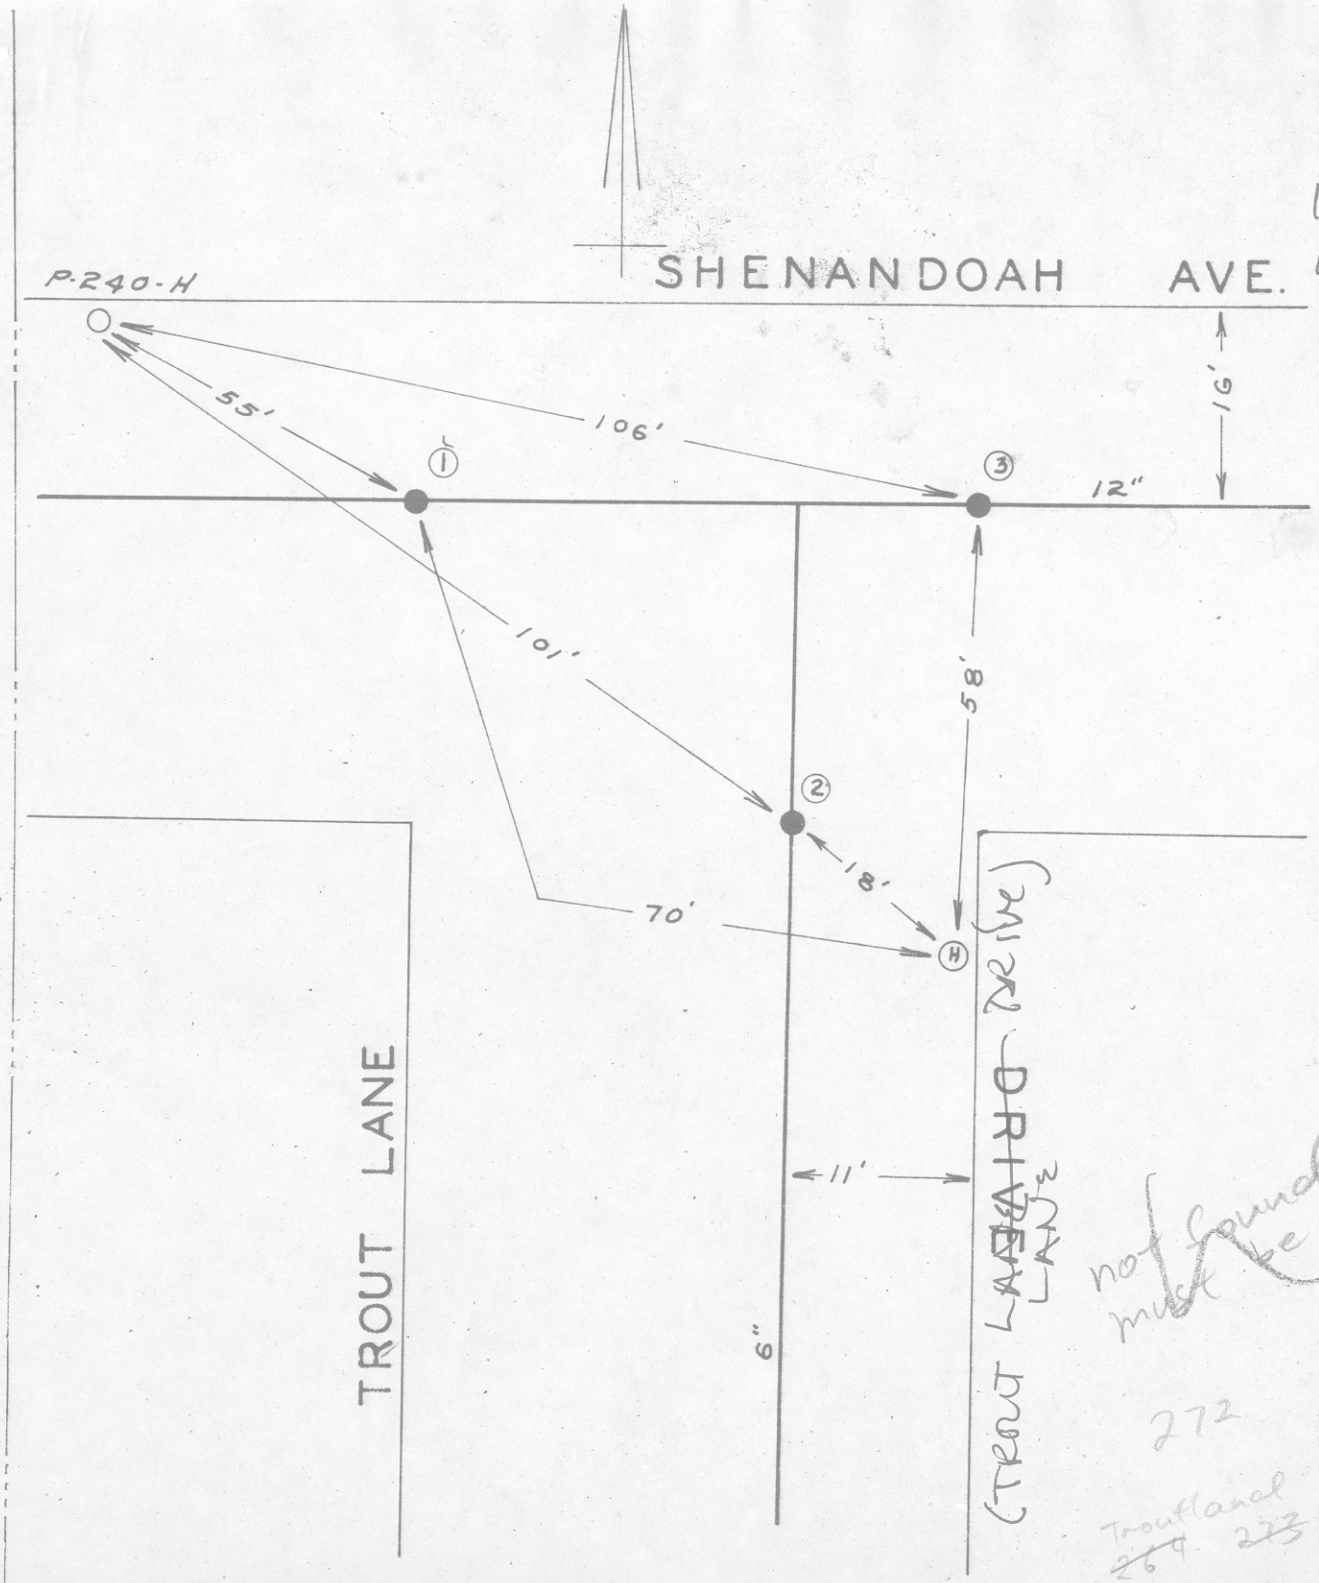

DATE	NO.	SIZE	MAKE	OPEN	TURNS
1952	1	12"	MUELLER	R	38
1952	2	6"	MUELLER	R	20
1952	3	12"	MUELLER	R	38
	1	0	WPL		
	2	0	SPL		
	3	0	EPL		

not found must be 3 lot street see map 251

272

Troutland ~~269~~ ~~273~~

CITY OF ROANOKE — WATER DEPT.

VALVE DIAGRAM

SHENADOAH AVE. &

TROUT LANE

SEC. MAP 222

DATE PAGE NO.

"IMPERIAL" TRACING CLOTH K & E CO., N. Y.