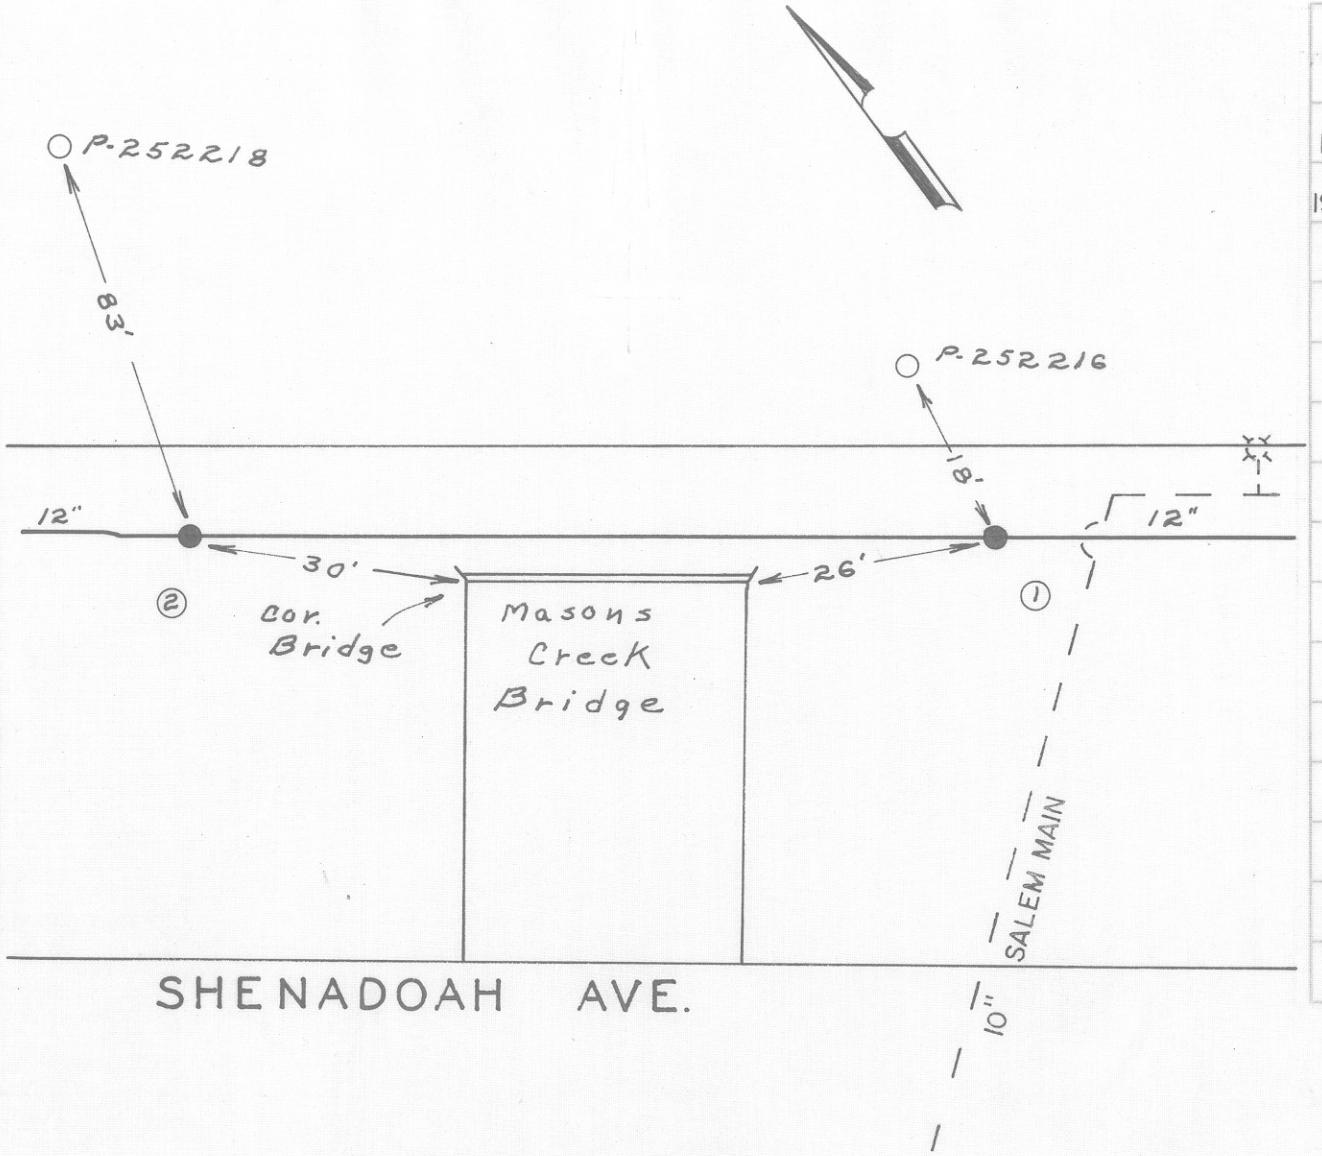

DATE	NO.	SIZE	MAKE	OPEN	TURNS
1955	1	12"			
1955	2	12"			

3/2001 JH

CITY OF ROANOKE — WATER DEPT.

VALVE DIAGRAM

SHENADOAH AVE. AT

MASONS CREEK BRIDGE

SEC. MAP 41

DATE PAGE NO.

"IMPERIAL" TRACING CLOTH K & E CO., N.Y.