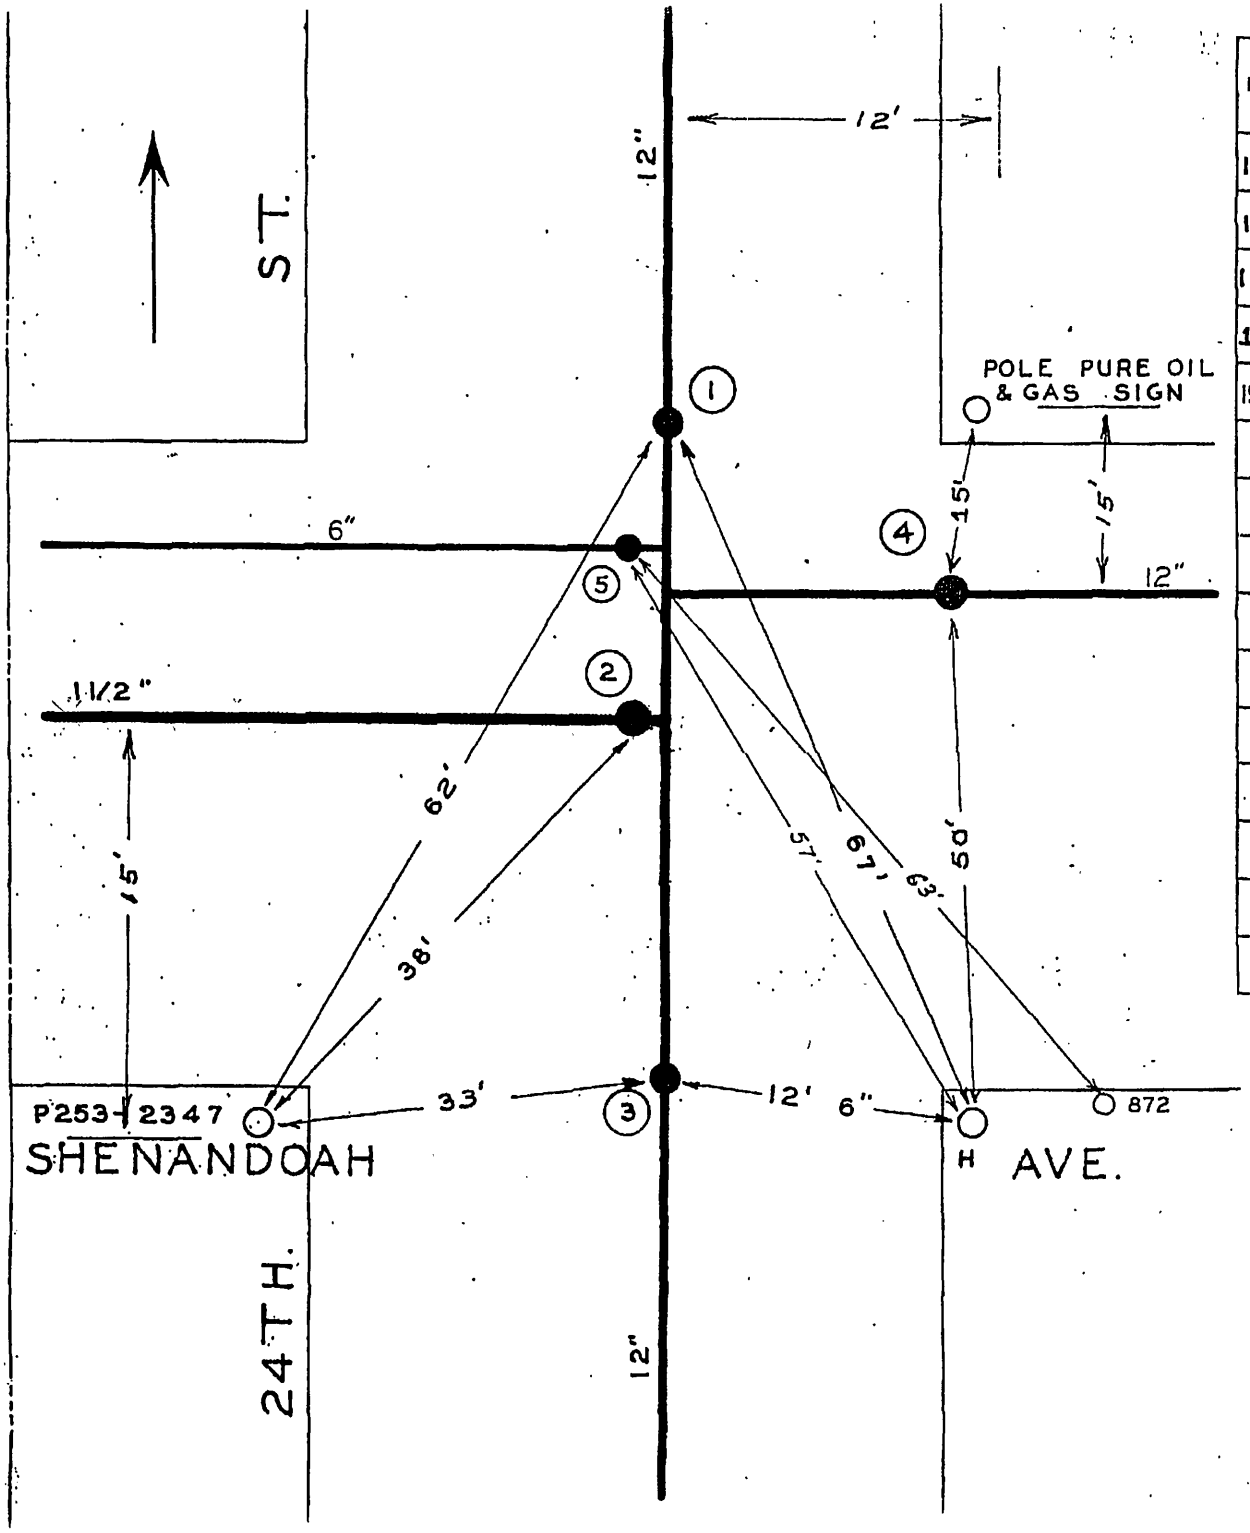

DATE	NO.	SIZE	MAKE	OPEN	TURNS
1937	1	12"		R	25
1923	2	2"		R	5 1/2
1937	3	12"		R	39
1949	4	12"	DARLING	R	39
1974	5	6"	MUELLER	R	
	1	0	NPL		
	2	39'-E	WPL		
	3	0	SPL		
	4	0	EPL		

CITY OF ROANOKE—WATER DEP'T

VALVE DIAGRAM

SHENANDOAH AVE & 24TH. ST. N.W.

SEC. MAP 231

DATE PAGE NO. NW.190