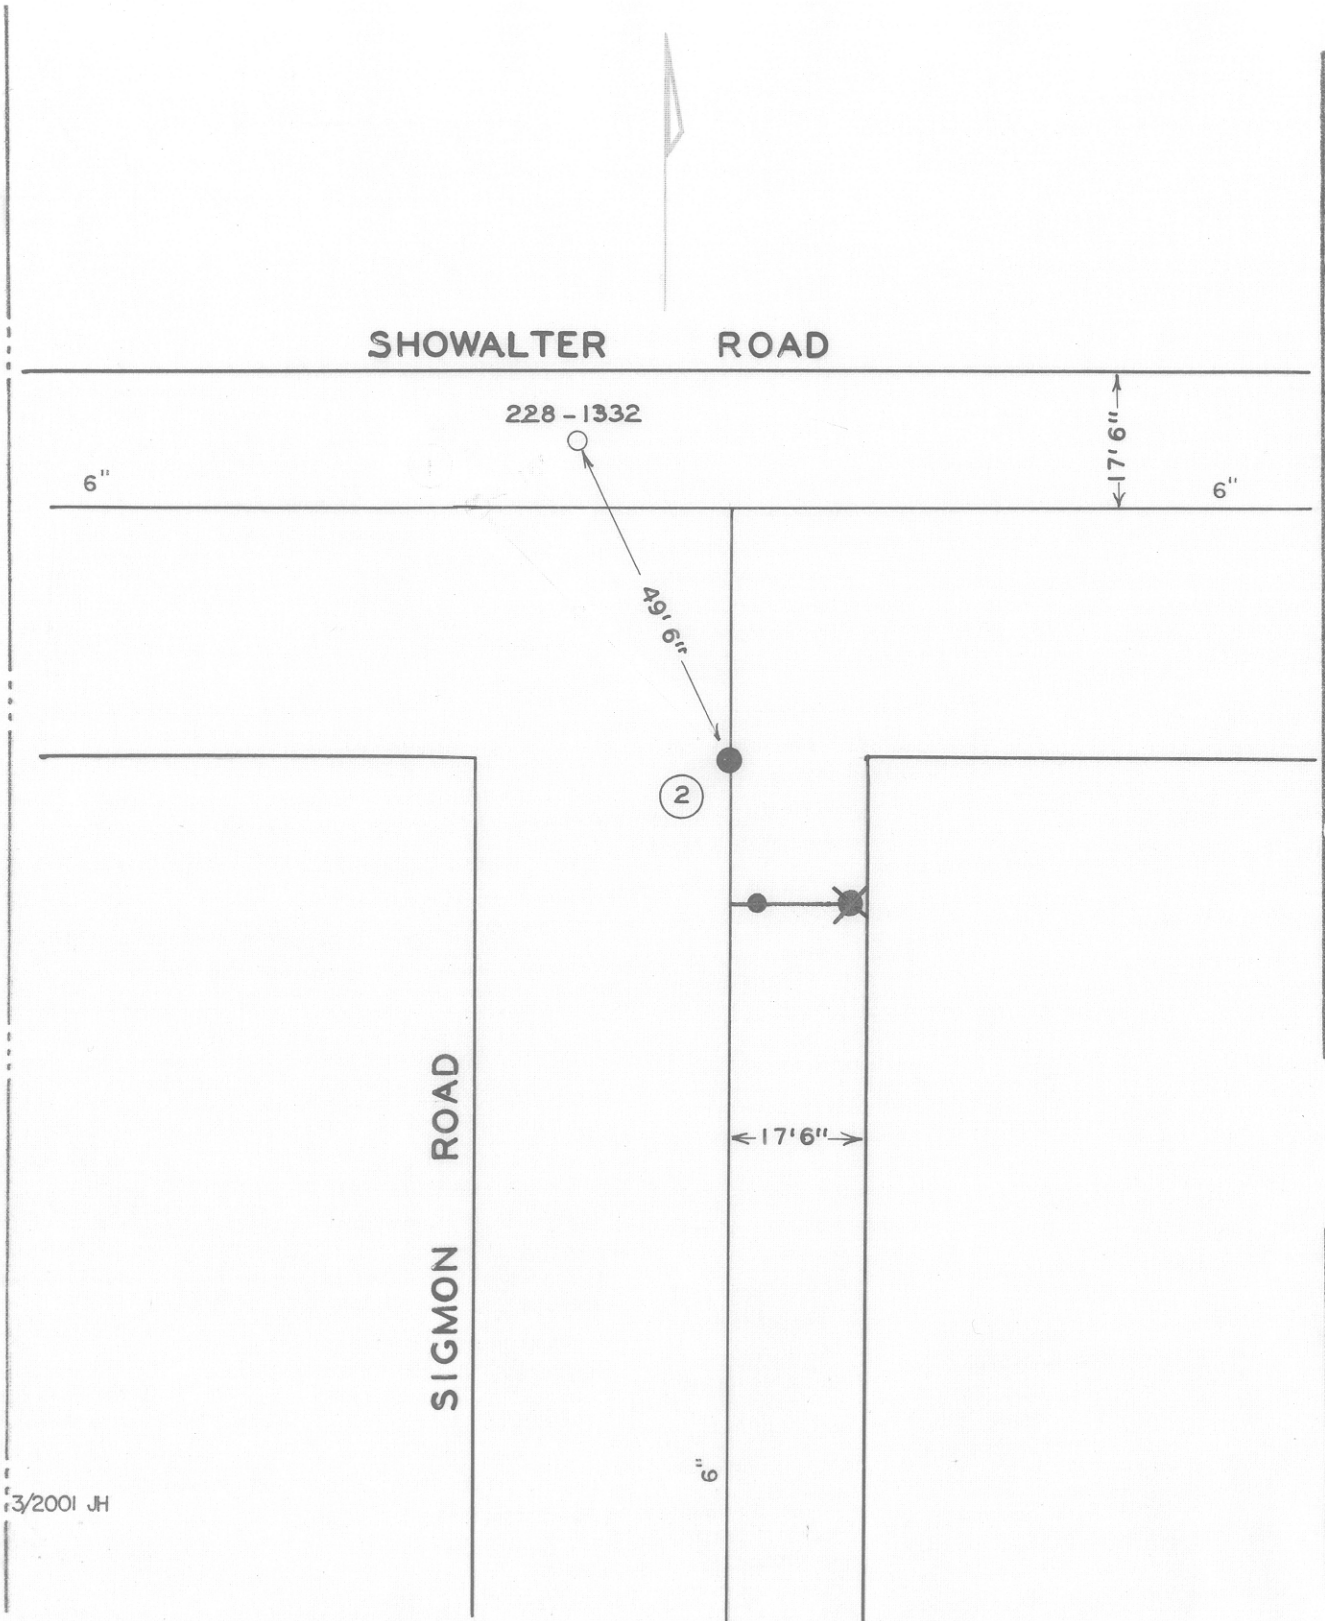

DATE	NO.	SIZE	MAKE	OPEN	TURNS
~~10-61~~	~~1~~	~~6"~~	~~MUELLER~~	~~R~~	~~20~~
10-61	2	6"	MUELLER	R	20
	~~1~~	~~0~~	~~WPL~~		
	2	0	SPL		

CITY OF ROANOKE — WATER DEPT.

VALVE DIAGRAM

SHOWALTER ROAD &

SIGMON ROAD N.W.

SEC. MAP 613 N.W.

DATE PAGE NO.