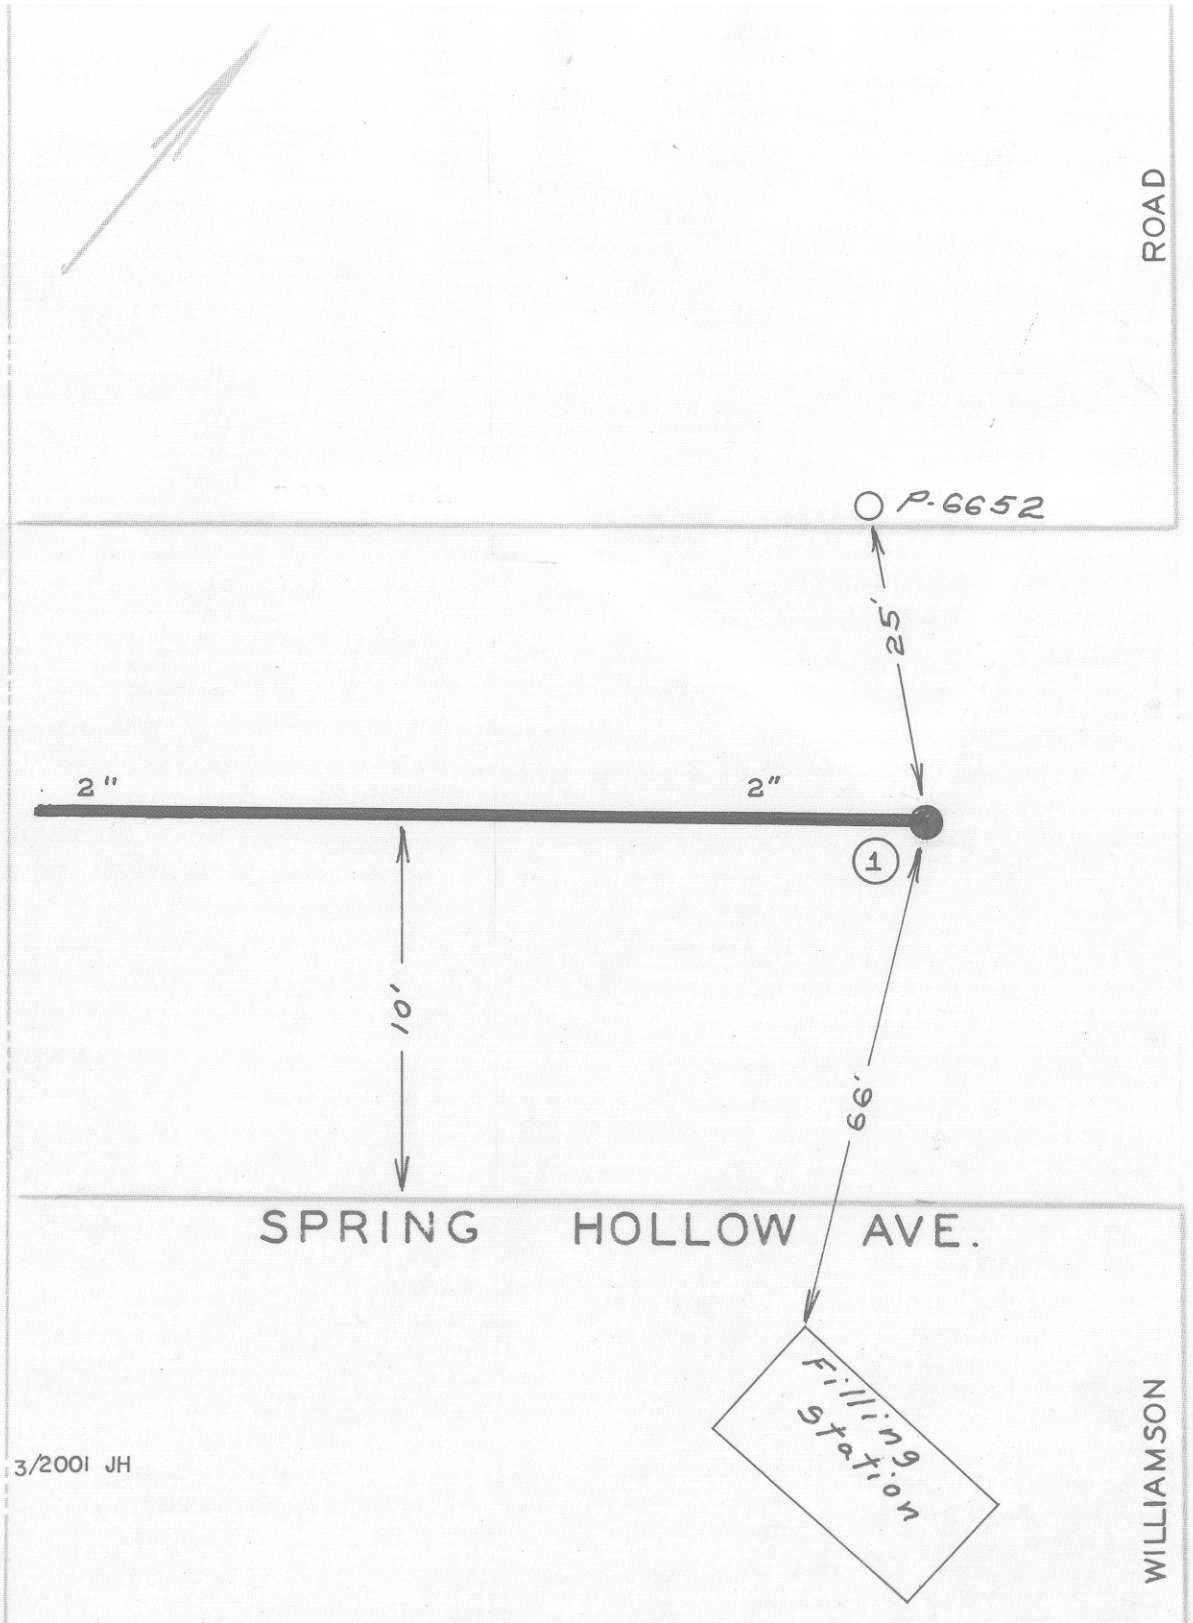

3/2001 JH

DATE	NO.	SIZE	MAKE	OPEN	TURNS
1948	1	2"	DARLING	R	7
	1	30'-S SPL WM. RD.			

CITY OF ROANOKE—WATER DEP'T

VALVE DIAGRAM

SPRING HOLLOW AVE. 30' S. OF WILLIAMSON ROAD N.W.

SEC. MAP 207

DATE 4/13/48 PAGE NO N.W. 300