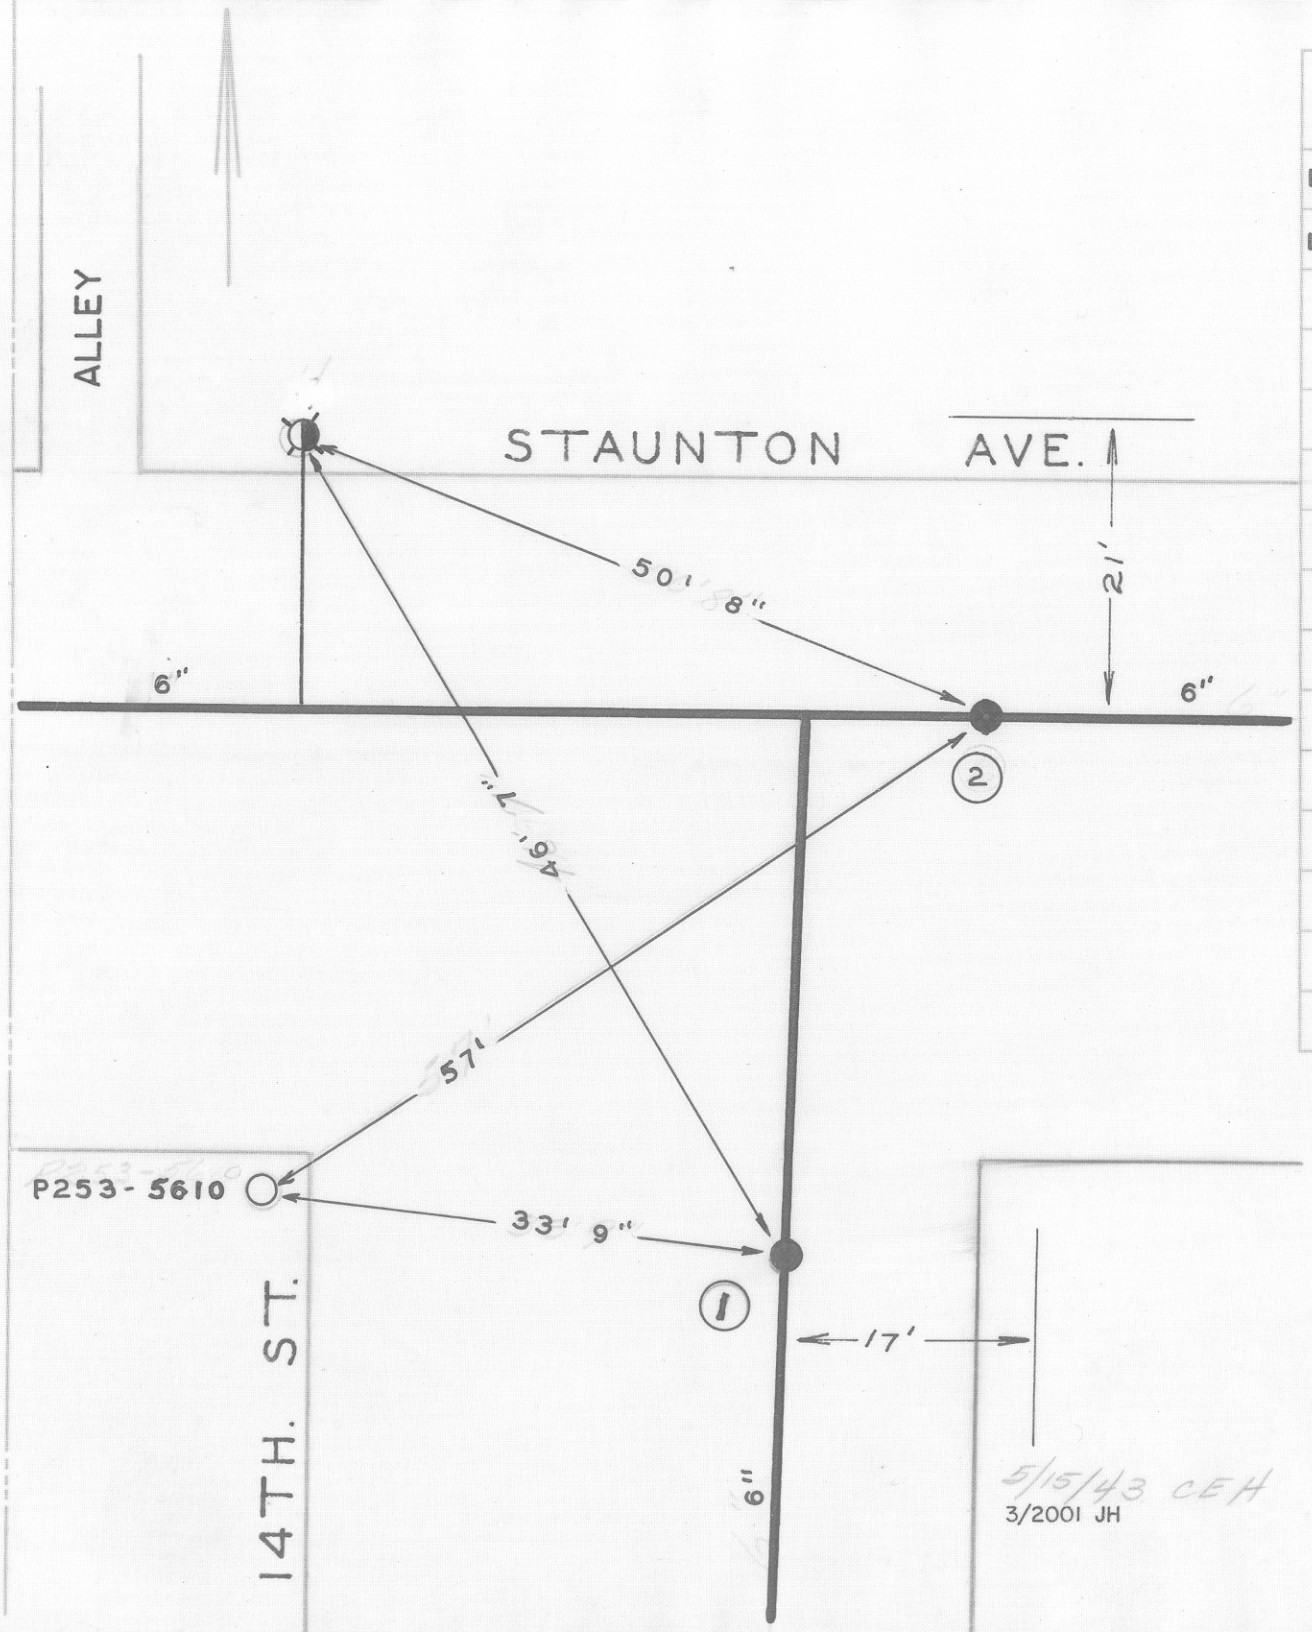

DATE	NO.	SIZE	MAKE	OPEN	TURNS
1927	1	6"		R	13
1914	2	6"		R	20 1/2
	1	18'-N	SPL		
	2	0	EPL		

CITY OF ROANOKE—WATER DEP'T

VALVE DIAGRAM

STAUNTON AVE. &

14 TH STREET

EAST INTERSECTION

SEC. MAP 223,222 N.W.

DATE PAGE NO. N.W. 160