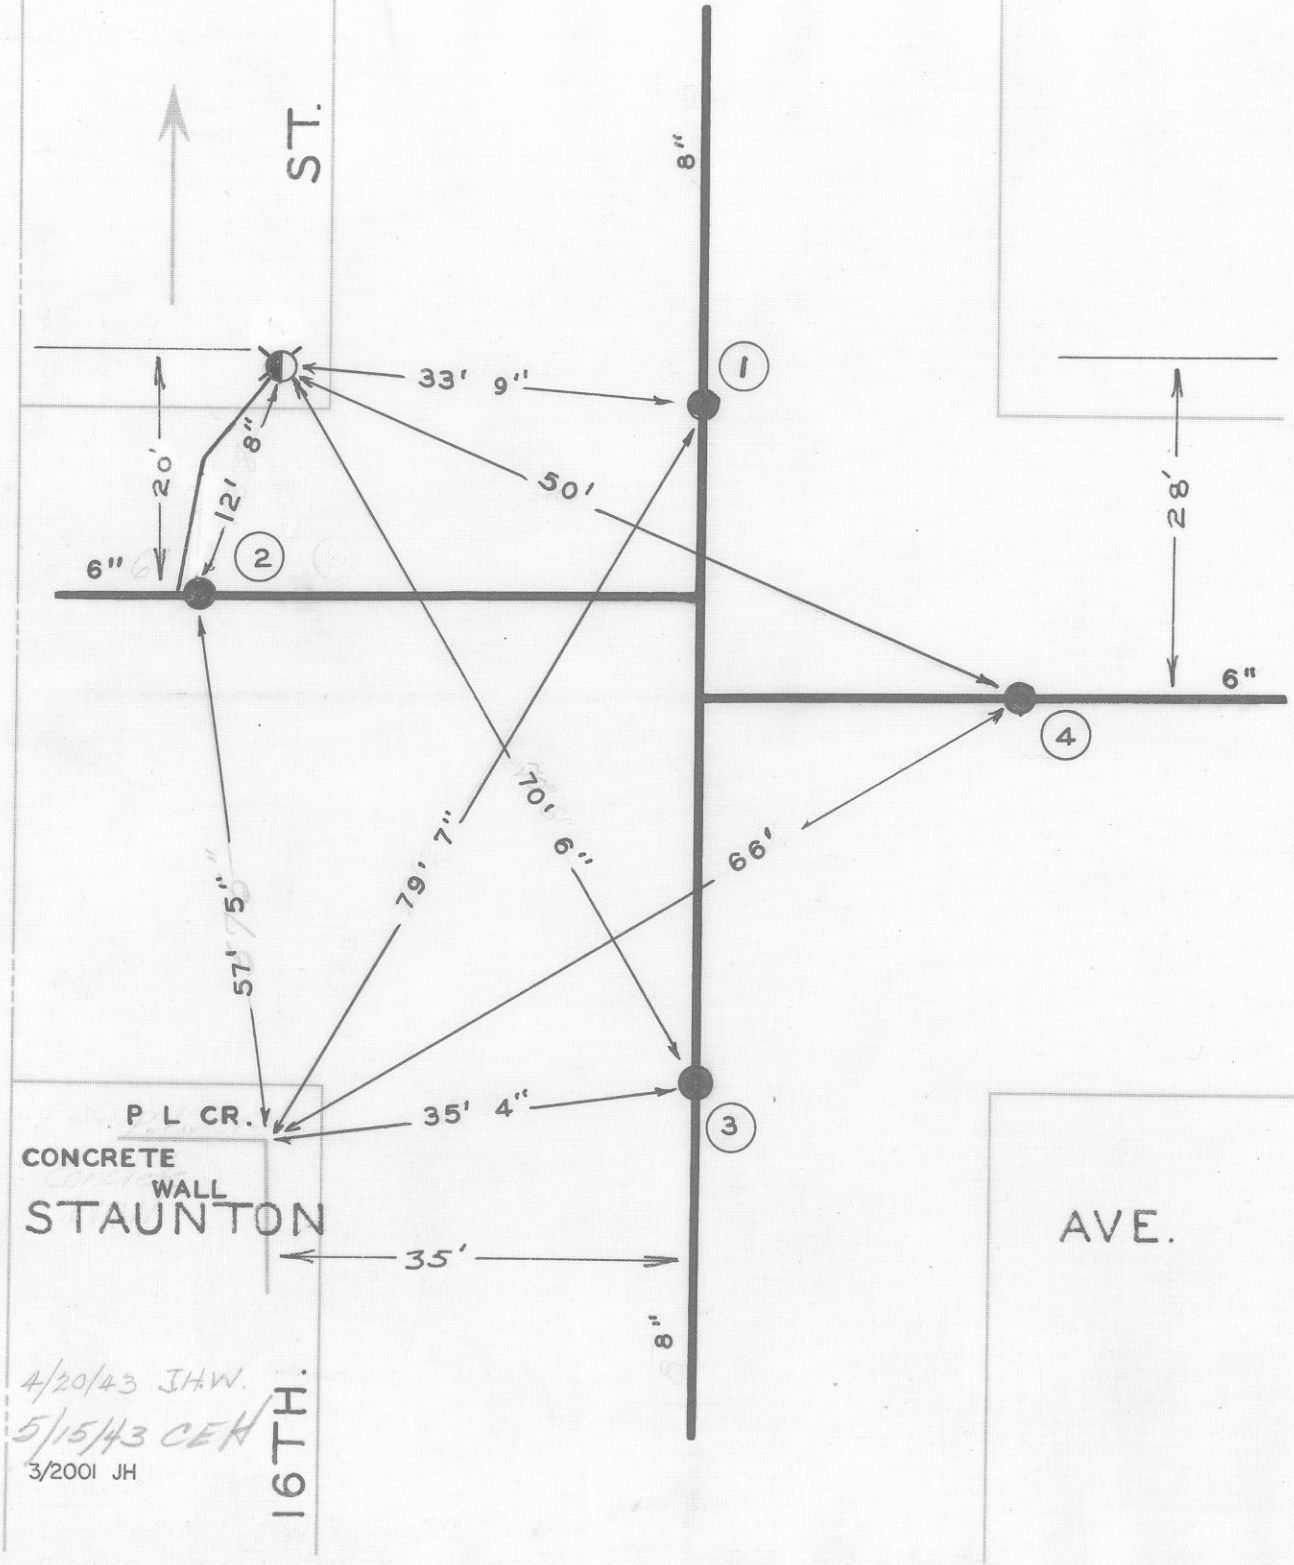

DATE	NO.	SIZE	MAKE	OPEN	TURNS
1939	1	8"		R	27
1939	2	6"		R	20
1939	3	8"		R	27 1/2
1939	4	6"		R	20
	1	8'-S	NPL		
	2	0	WPL		
	3	8'-N	SPL		
	4	0	EPL		

CITY OF ROANOKE—WATER DEP'T

VALVE DIAGRAM

STAUNTON AVE. & 16TH.

16 TH STREET

SEC. MAP 223 , 222 N.W.

DATE PAGE NO. NW 164