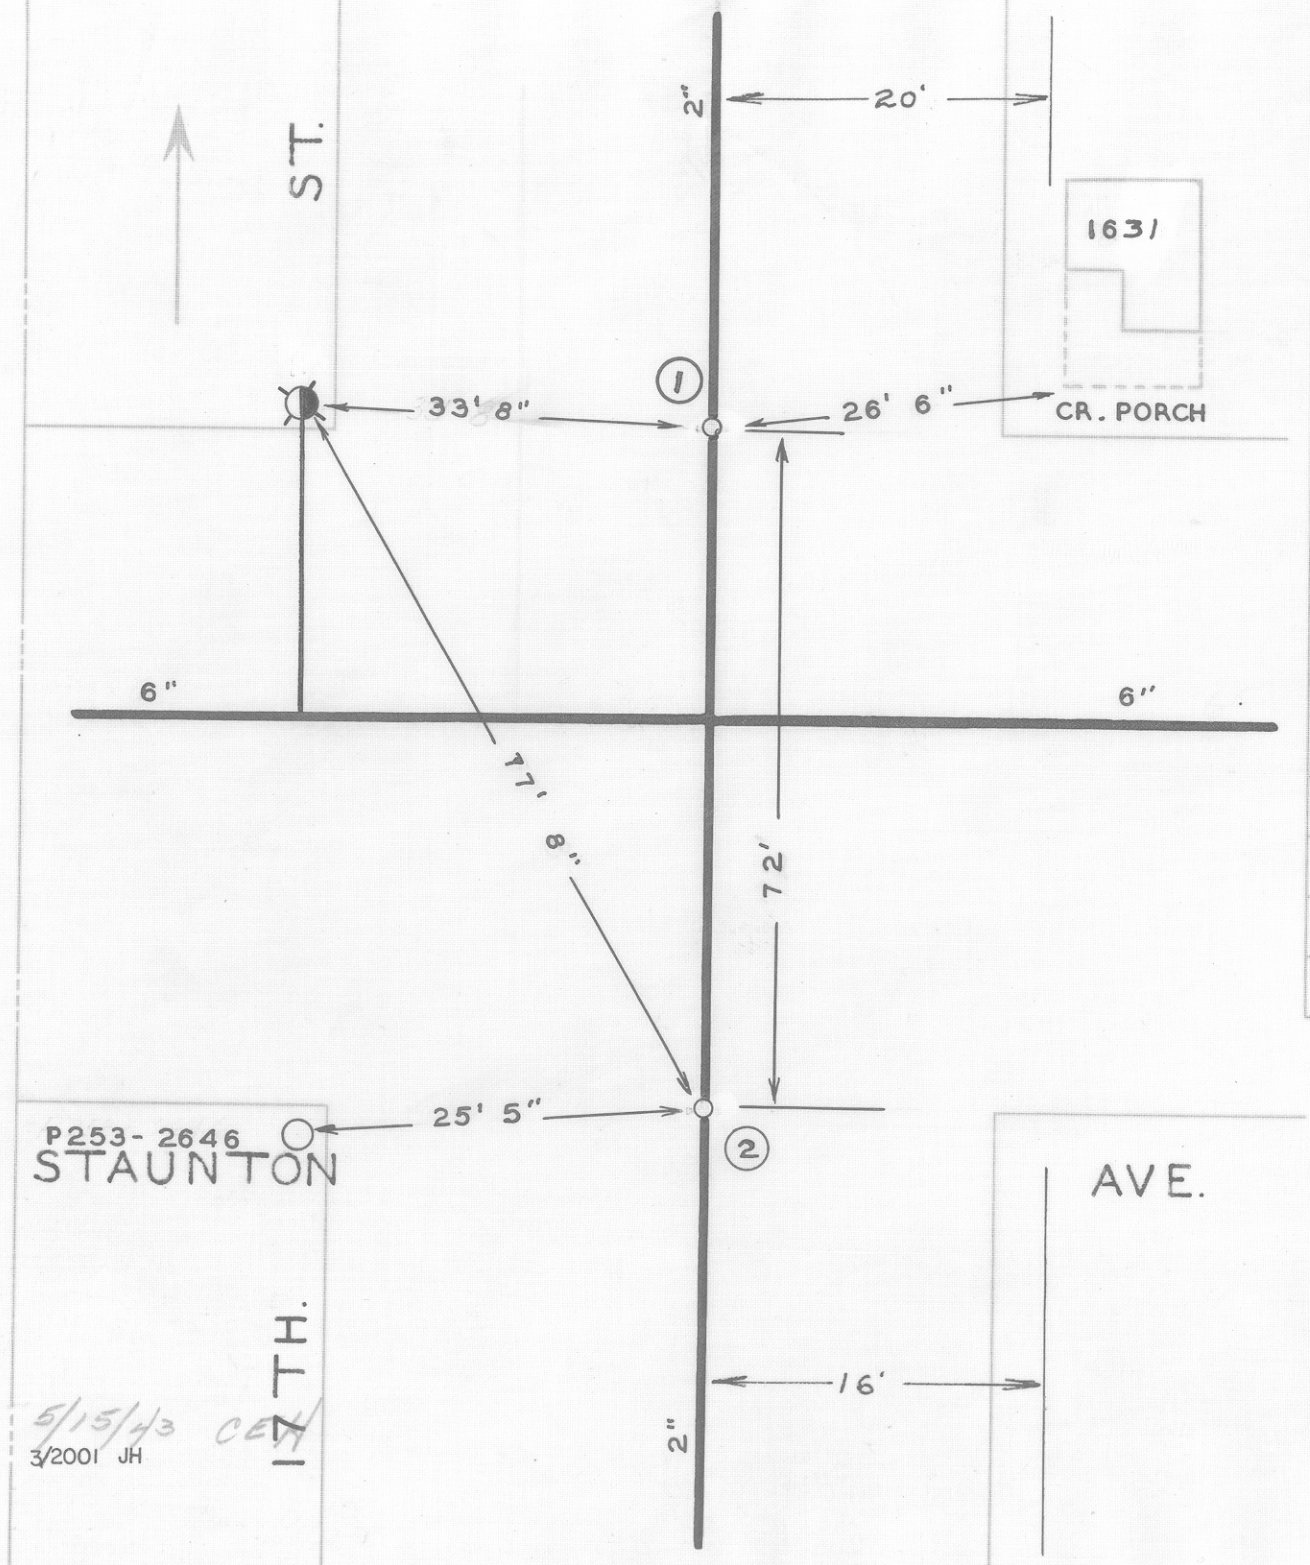

DATE	NO.	SIZE	MAKE	OPEN	TURNS
1920	1	2"		L	7
1923	2	2"		R	7
	1	7'-S	NPL		
	2	0	SPL		

CITY OF ROANOKE—WATER DEP'T

VALVE DIAGRAM

STAUNTON AVE. &

17 TH STREET

SEC. MAP 233, 222 N.W.

DATE PAGE NO. NW.218