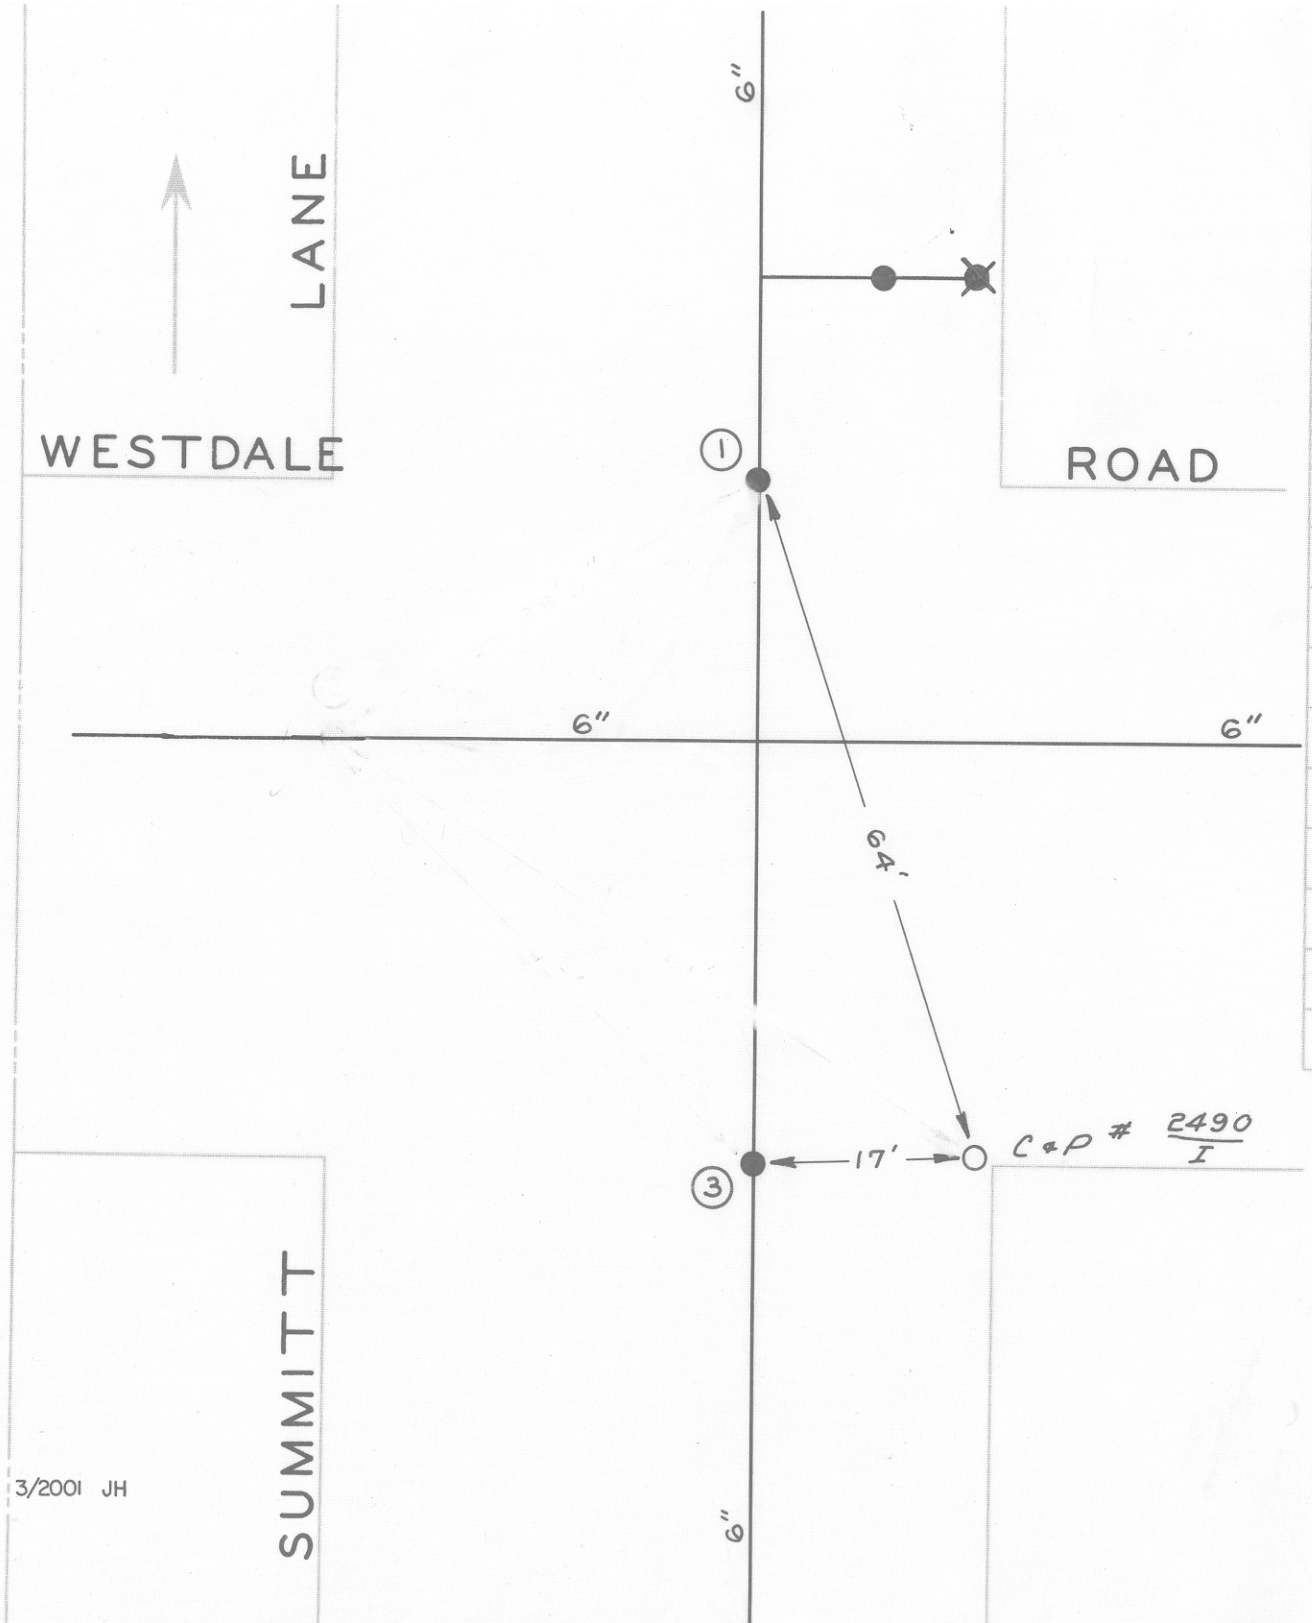

DATE	NO.	SIZE	MAKE	OPEN	TURNS
'59	1	6"	MUELLER	R	20
'59	2	6"	MUELLER	R	20
'59	3	6"	DARLING	R	20
	1	0	NPL		
	2	0	WPL		
	3	0	SPL		

CITY OF ROANOKE—WATER DEP'T

VALVE DIAGRAM

SUMMITT LANE &
WESTDALE ROAD

SEC. MAP 607 N.W.

DATE PAGE NO.

3/2001 JH