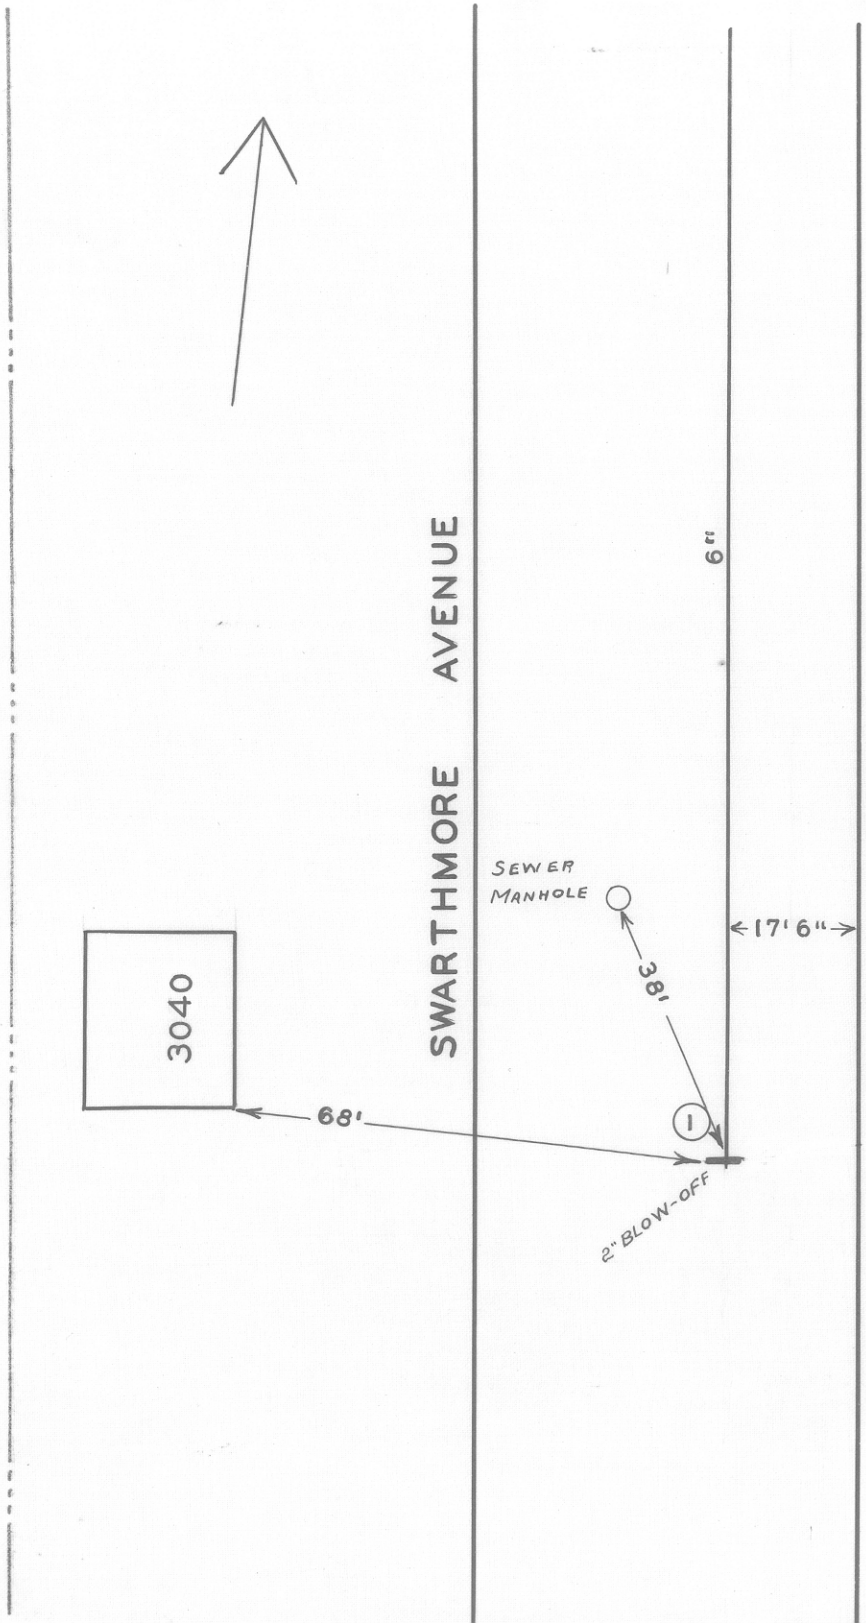

DATE	NO.	SIZE	MAKE	OPEN	TURNS
3-63	1	2"	MISC.		

CITY OF ROANOKE — WATER DEPT.

VALVE DIAGRAM

SWARTHMORE AVENUE N.W.

SEC. MAP 248

DATE PAGE NO.