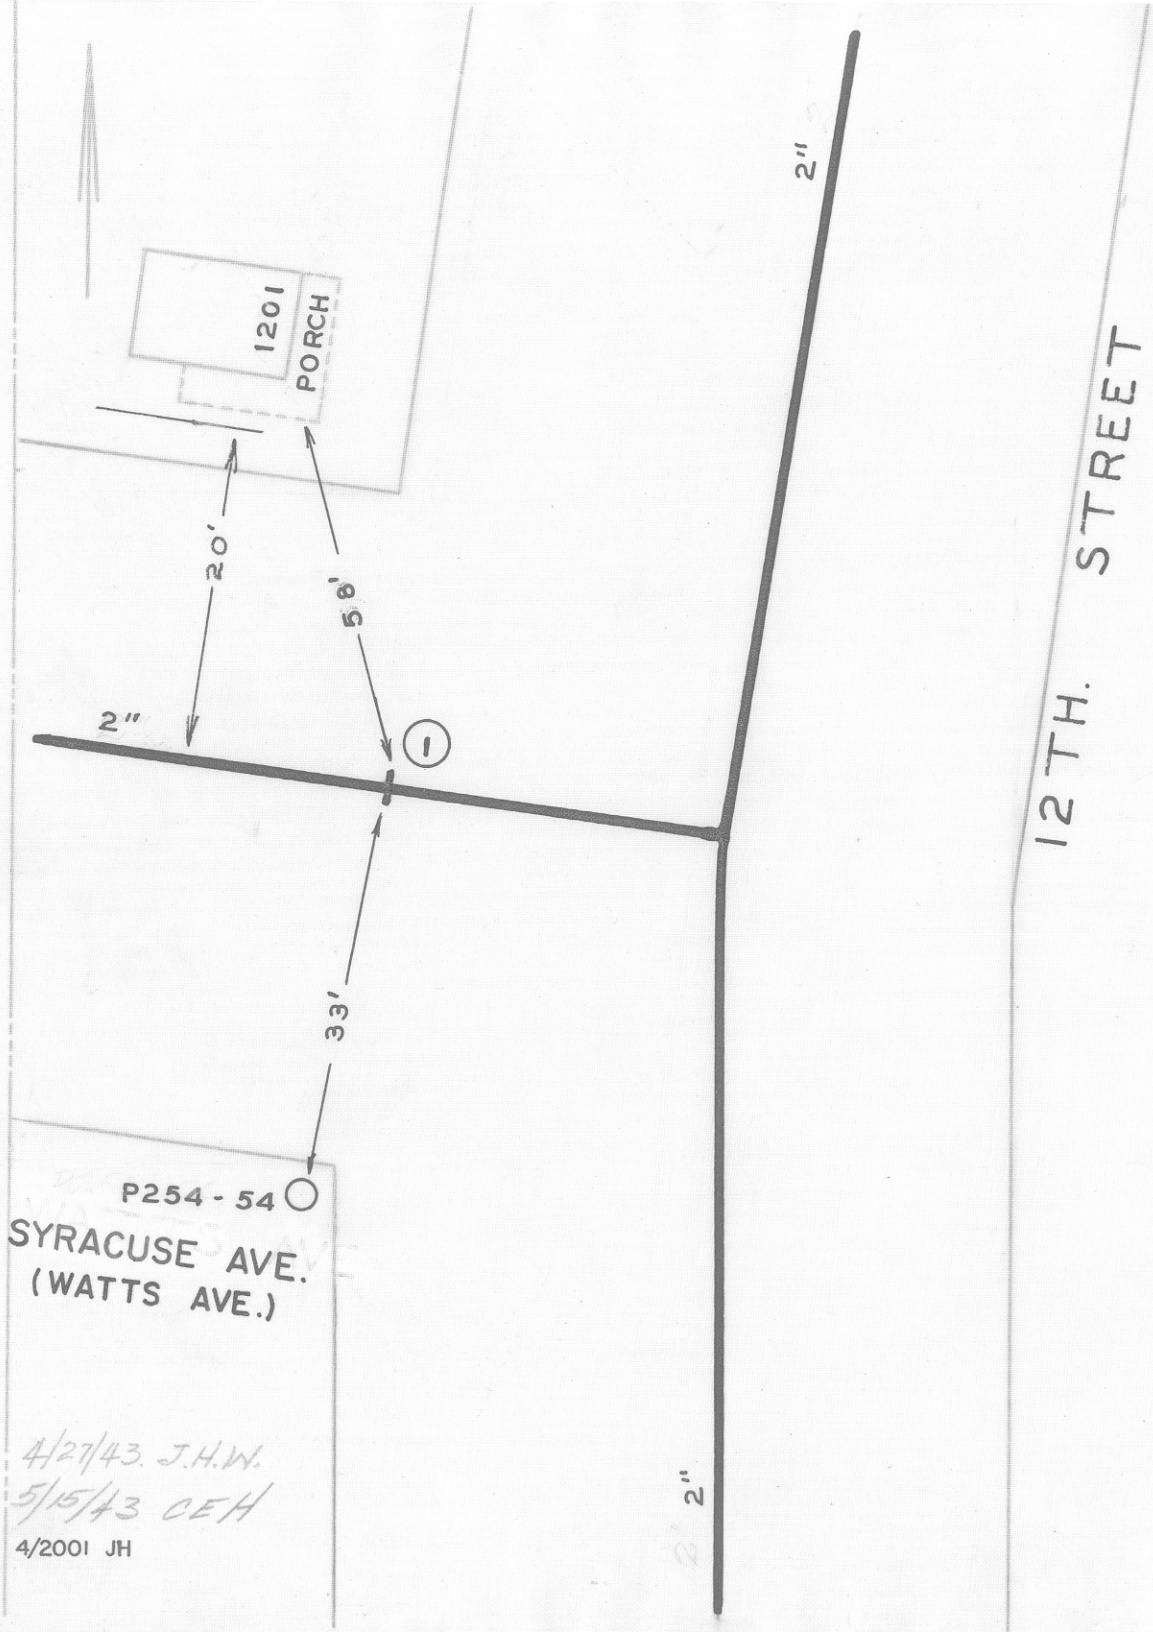

DATE	NO.	SIZE	MAKE	OPEN	TURNS
1928	1	2"		L	7 1/2
	1	16'-E	WPL		

CITY OF ROANOKE—WATER DEP'T

VALVE DIAGRAM

SYRACUSE AVENUE &
12 TH. STREET

SEC. MAP 223 N.W.

DATE PAGE NO NW 184