DATE	NO.	SIZE	MAKE	OPEN	TURNS
1937	1	2"		R	7
1937	2	2"		R	7
1947	3	2"	DARLING	R	7
	1	7'-E	WPL		
	2	12'-S	SPL		
	3	0	EPL		

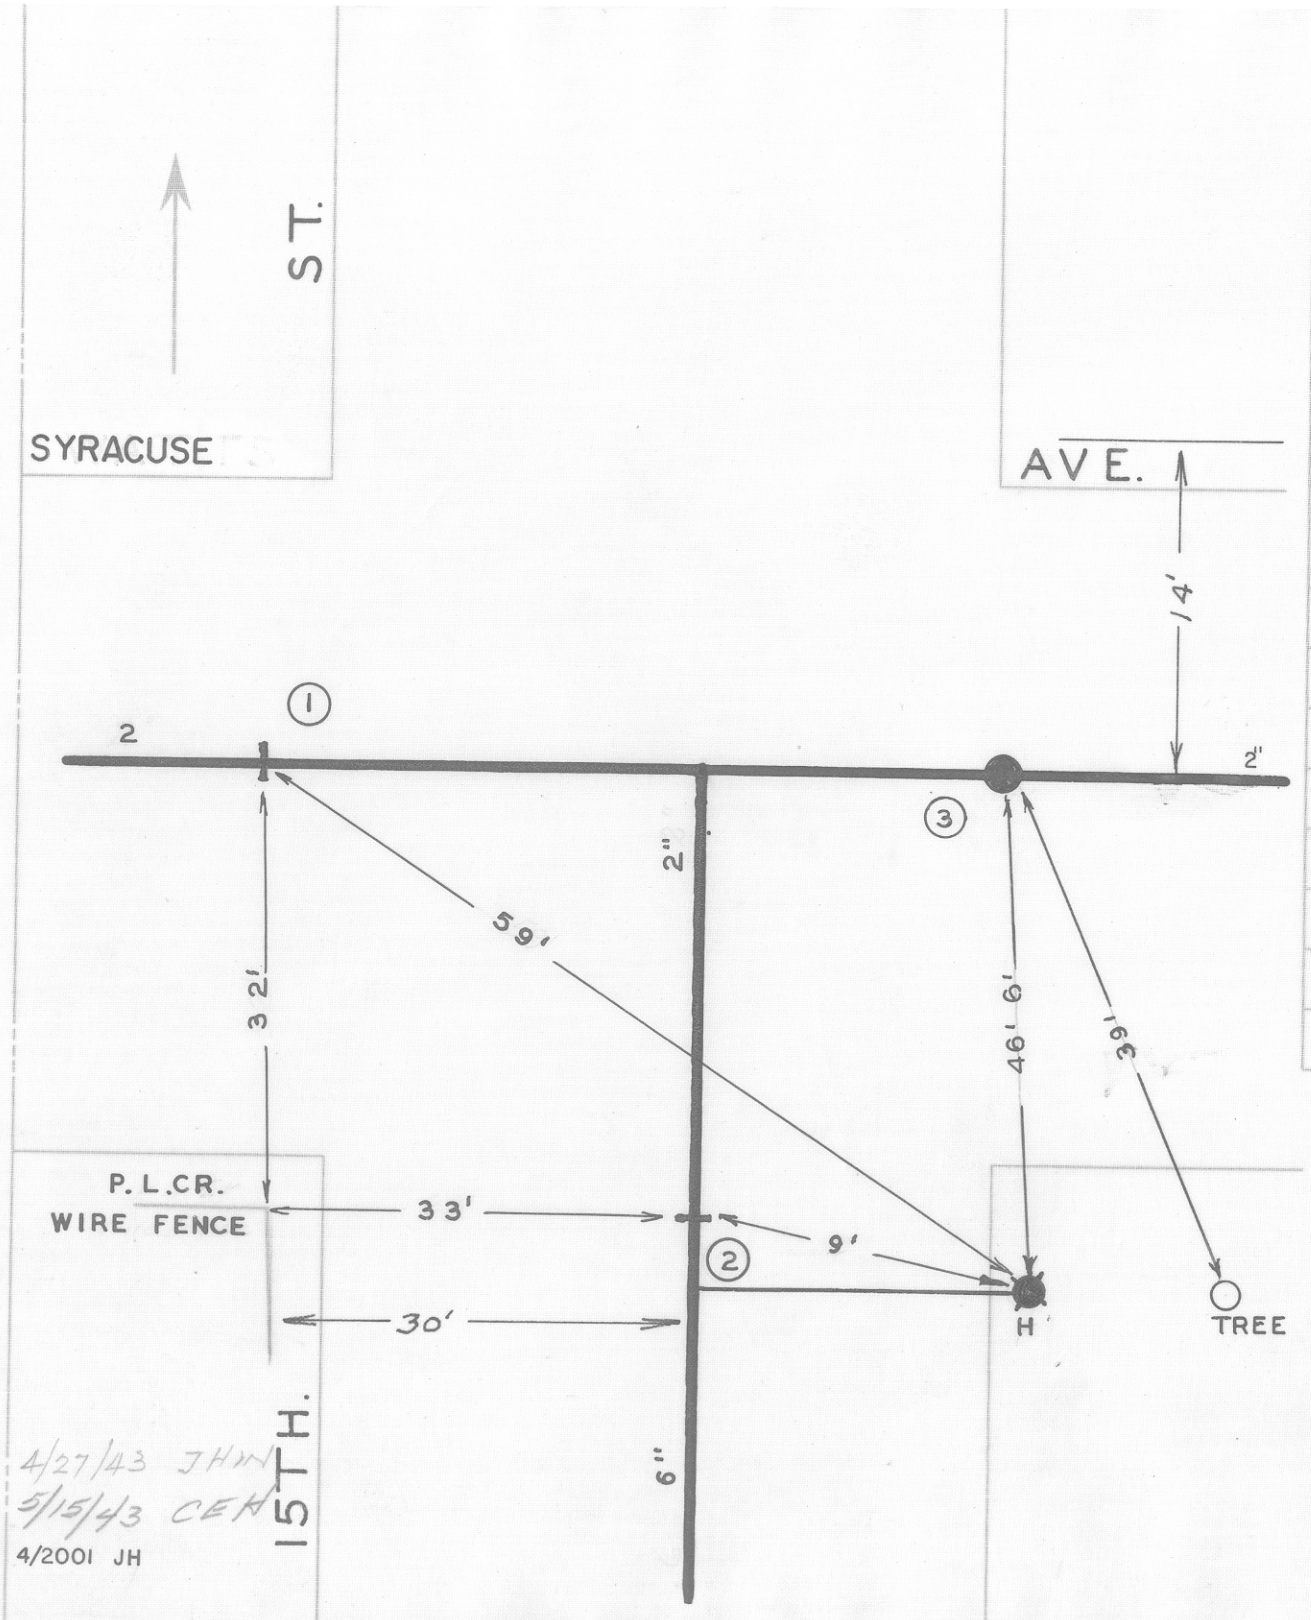

CITY OF ROANOKE—WATER DEP'T

VALVE DIAGRAM

SYRACUSE AVENUE &

15 TH. STREET

SEC. MAP 223 N.W.

DATE PAGE NO. NW. 185