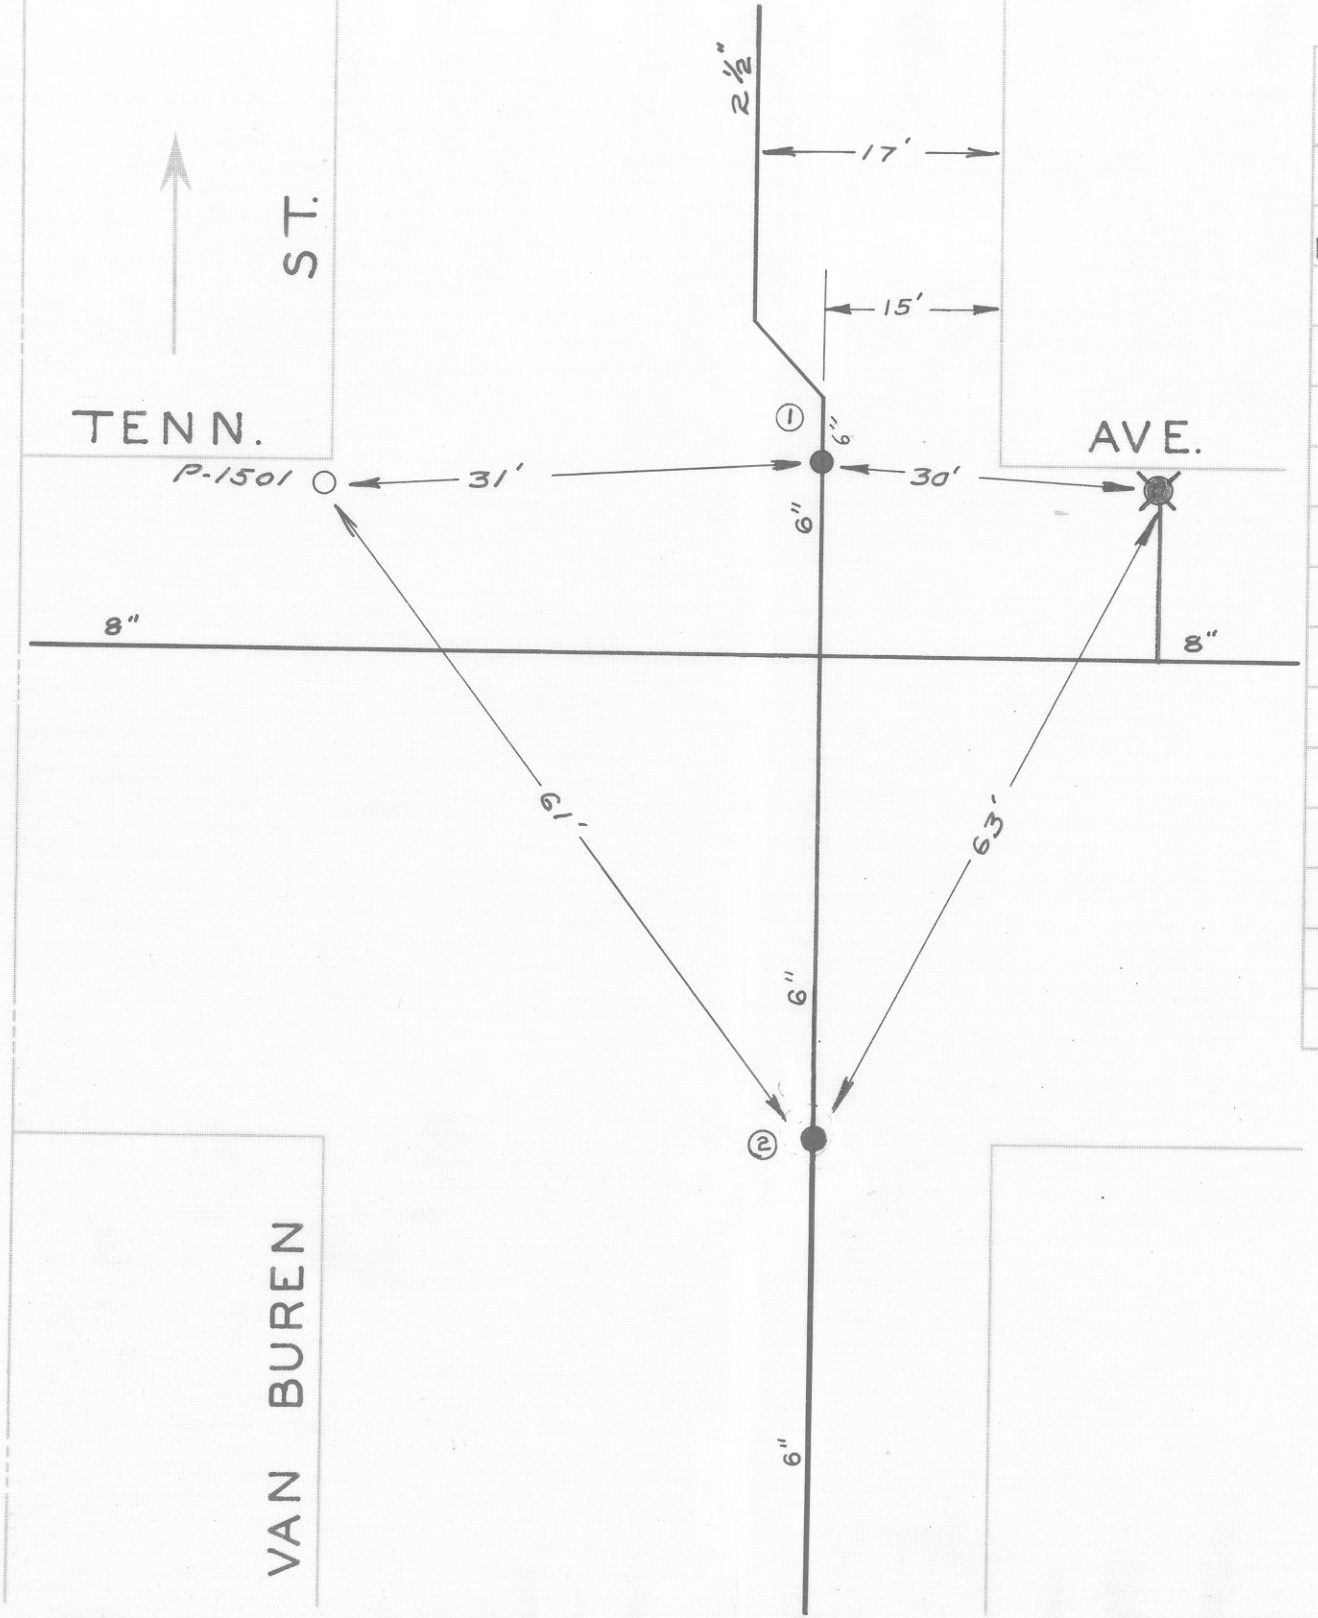

DATE	NO.	SIZE	MAKE	OPEN	TURNS
1953	1	6"	MUELLER	R	20
1953	2	6"	MUELLER	R	20
	1	0	NPL		
	2	0	SPL		

CITY OF ROANOKE—WATER DEP'T

VALVE DIAGRAM

TENNESSEE AVE. &

VAN BUREN ST. N. W.

SEC. MAP 277, 276

DATE PAGE NO.