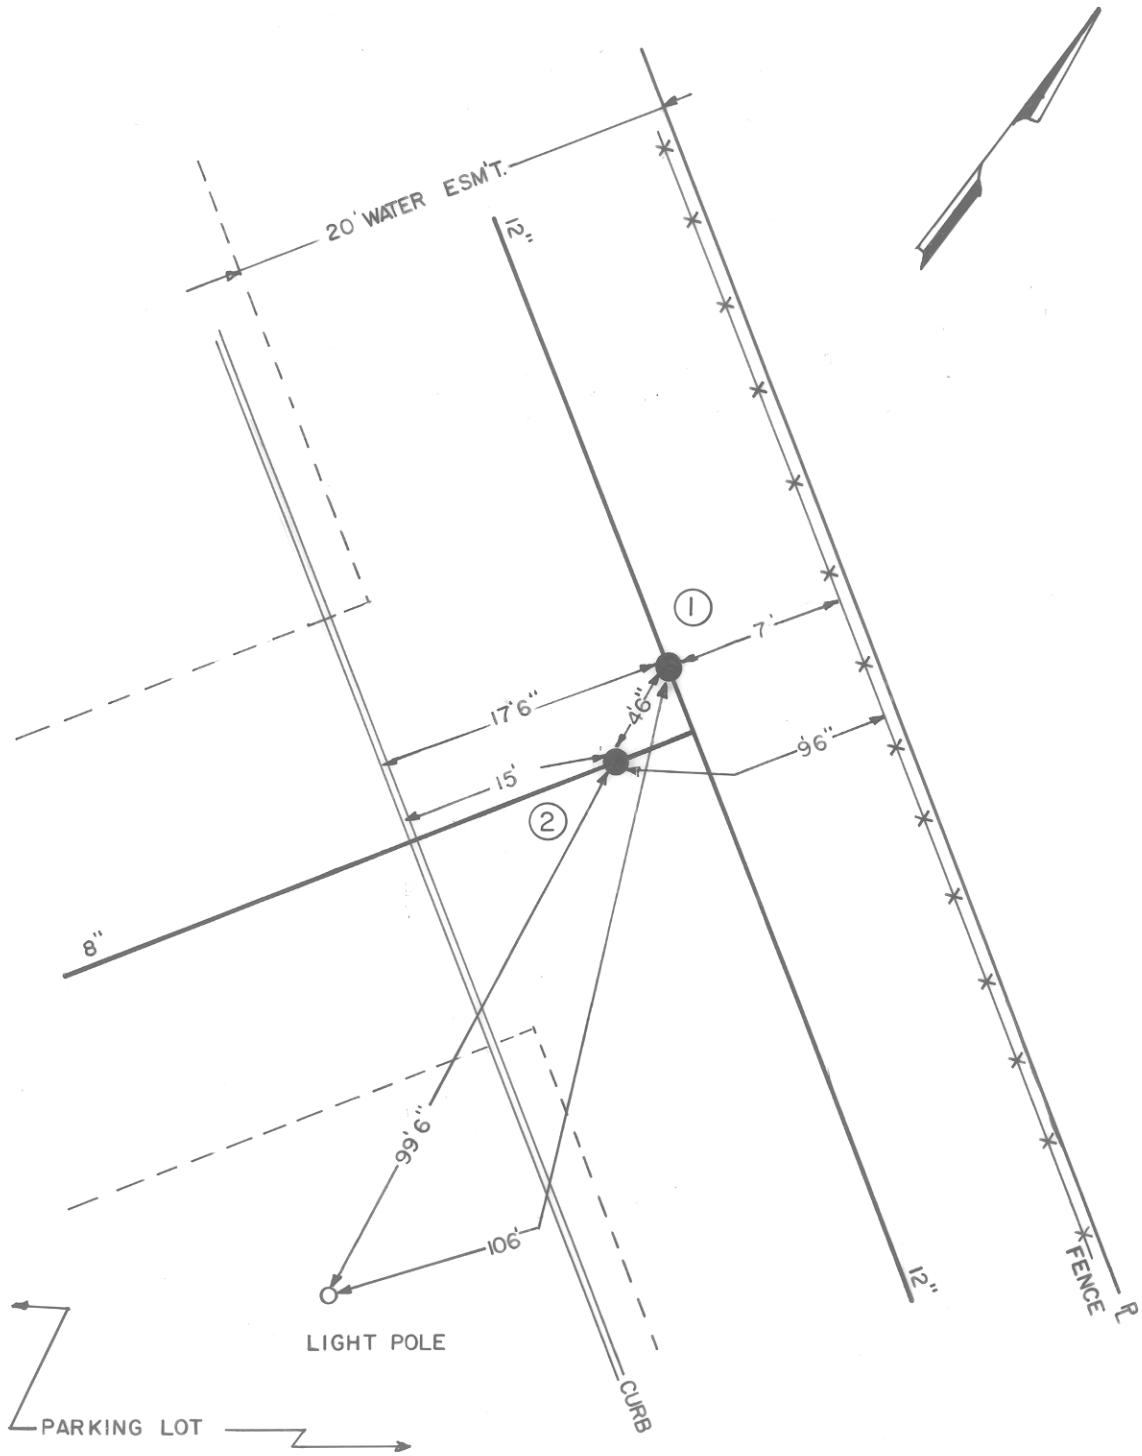

DATE	NO.	SIZE	MAKE	OPEN	TURNS
1984	1	12"			
1984	2	8"			

CITY OF ROANOKE - WATER DEP'T.

VALVE DIAGRAM

3601 THIRLANE ROAD

VALLEY COURT - IN ESM'T.

EAST OF BUILDING

SEC. MAP 653 N.W.

DATE: PAGE NO.

3/92 NP
3/2001 JH