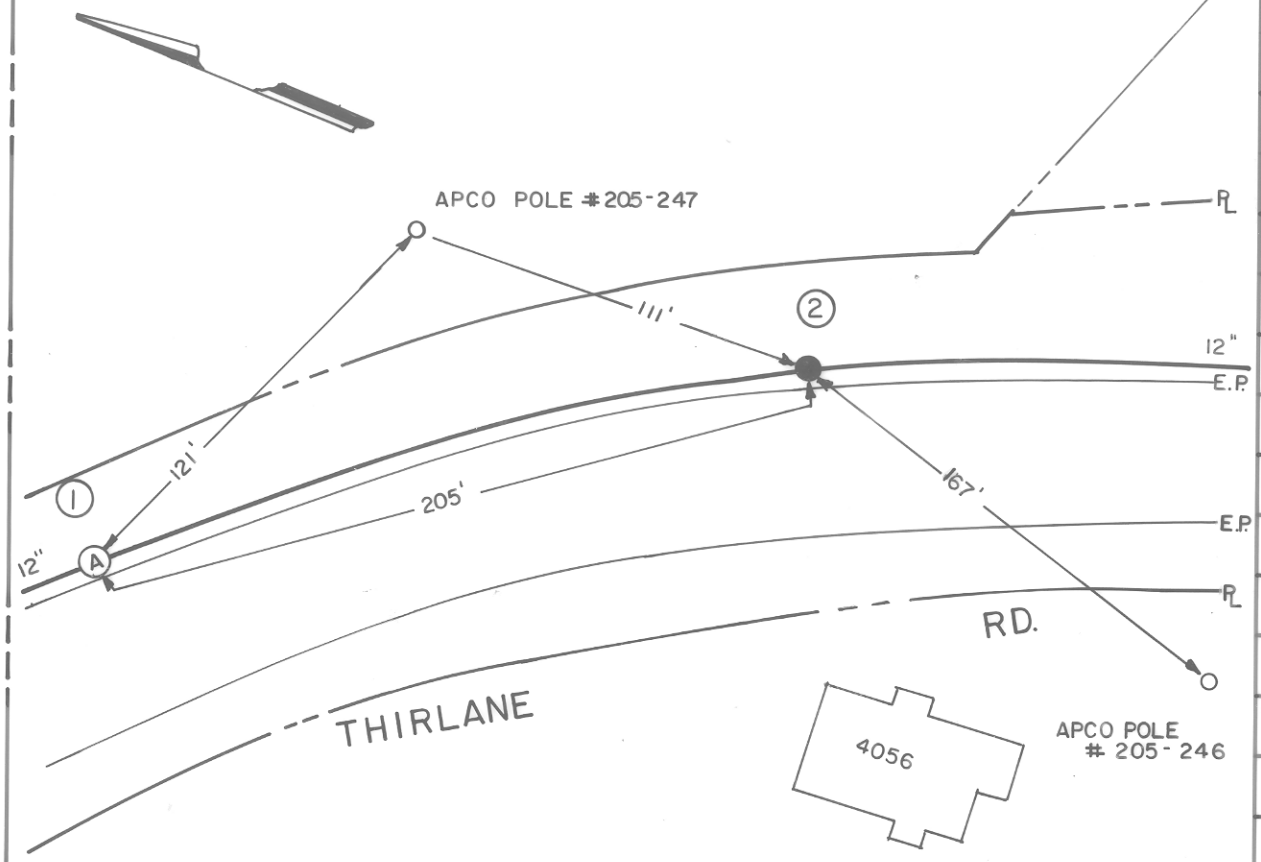

DATE	NO.	SIZE	MAKE	OPEN	TURNS
1991	1	12"	AIR RELEASE VALVE		
1991	2	12"	MUELLER	R	

CITY OF ROANOKE - WATER DEP'T.

VALVE DIAGRAM

THIRLANE ROAD

4000 BLOCK

(250' N. OF CUSTOMER'S ENTR. TO U.P.S.)

SEC. MAP 651 N.W.

DATE: PAGE NO.

3/92 NP