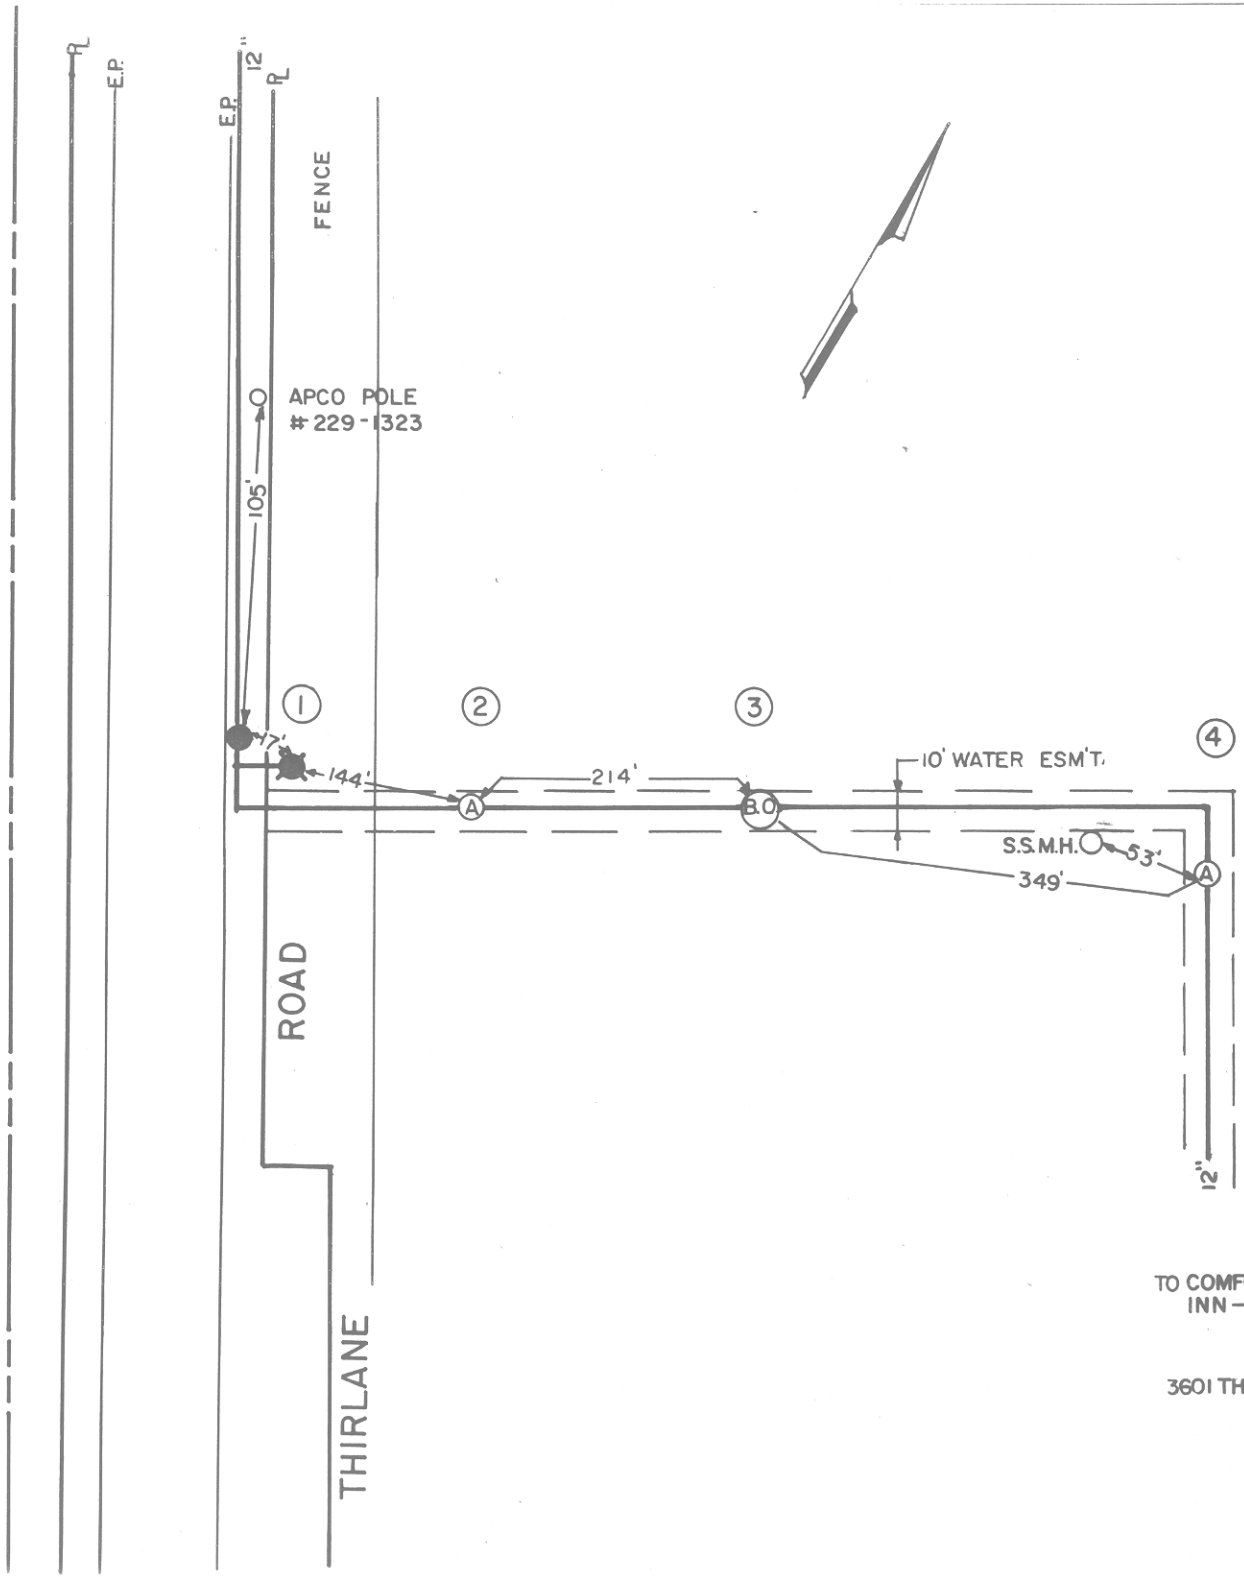


| DATE | NO. | SIZE | MAKE | OPEN | TURNS |
|---|---|---|---|---|---|
| 1991 | 1 | 12" | MUELLER | R | |
| 1991 | 2 | 12" | AIR RELEASE VALVE | | |
| 1991 | 3 | 2" | BLOW OFF | | |
| 1991 | 4 | 12" | AIR RELEASE VALVE | | |
| | | | | | |
| | | | | | |
C OIL

CITY OF ROANOKE - WATER DEP'T.

# VALVE DIAGRAM

THIRLANE ROAD

EASEMENT-3700 BLOCK

500' N. COMFORT INN ENTR.

SEC. MAP 653 N.W.

DATE: PAGE NO.