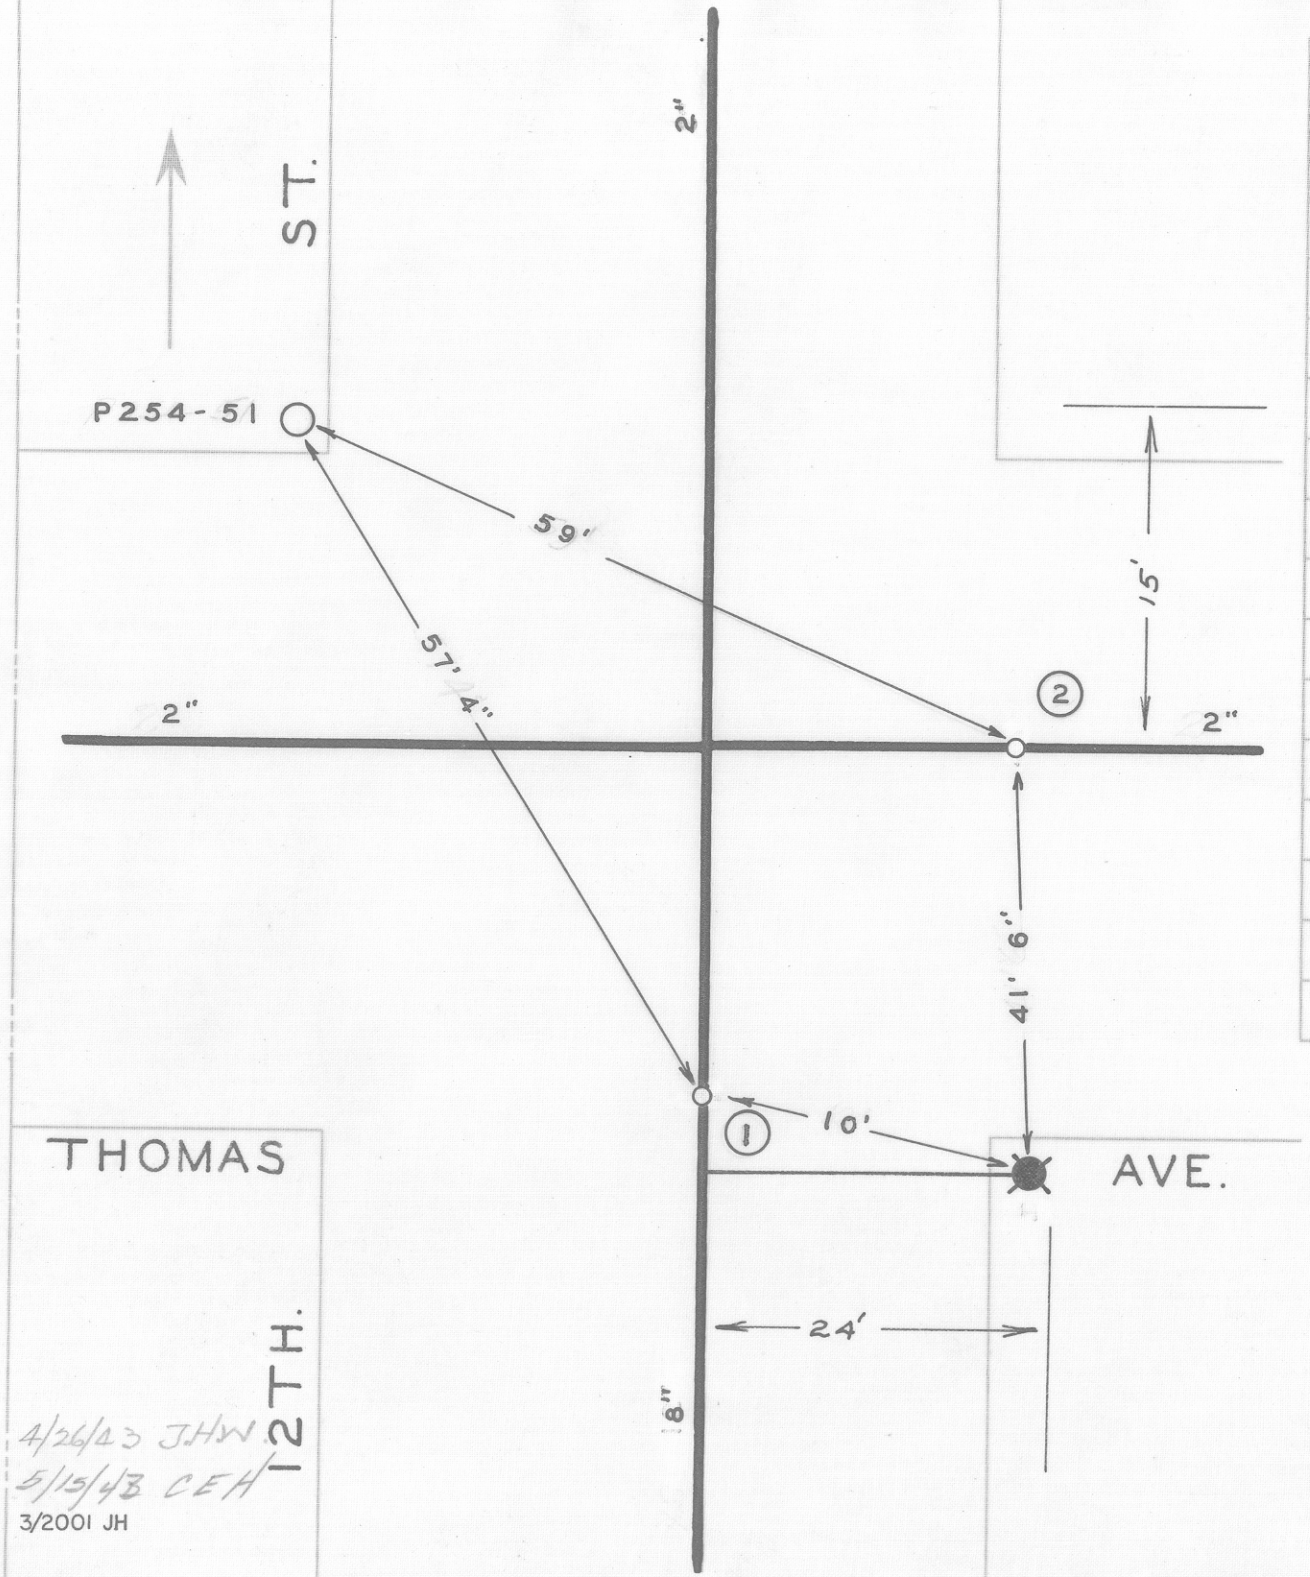

DATE	NO.	SIZE	MAKE	OPEN	TURNS
1939	1	2"		R	7
1925	2	2"		R	8 1/2
	1	15'-S	SPL		
	2	0	EPL		

4/26/43 JHW
5/15/43 CEH
3/2001 JH

CITY OF ROANOKE—WATER DEP'T
VALVE DIAGRAM

THOMAS AVE. & 12TH.
12 TH. STREET

SEC. MAP 223 N.W.

DATE PAGE NO. NW,182