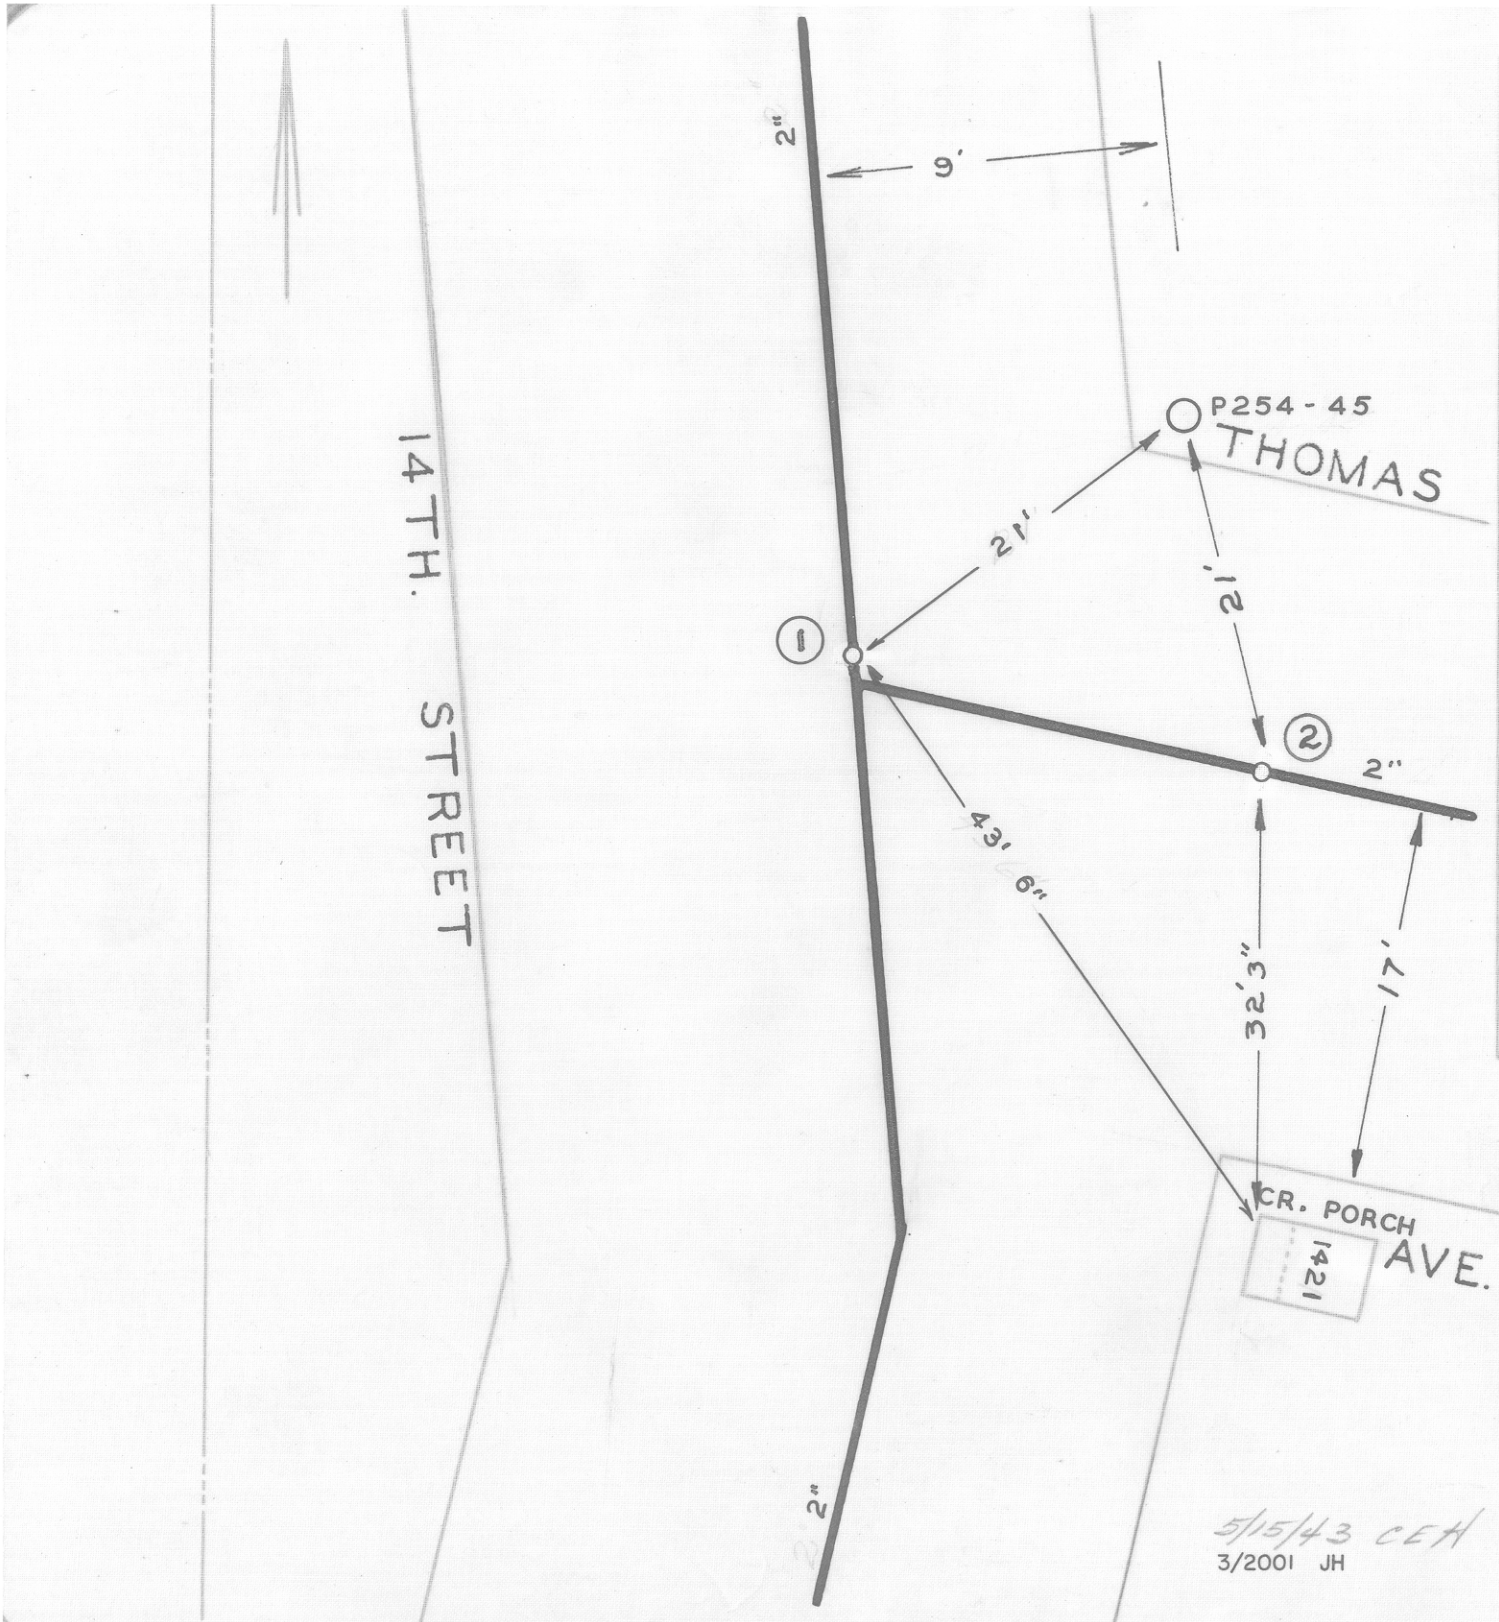

DATE	NO.	SIZE	MAKE	OPEN	TURNS
1919	1	2"		R	5
1919	2	2"			
	1	26'-S	NPL		

5/15/43 CEH
3/2001 JH

CITY OF ROANOKE—WATER DEP'T
VALVE DIAGRAM

THOMAS AVE. &
14 TH. STREET

SEC. MAP 223 N.W.

DATE PAGE NO NW 183