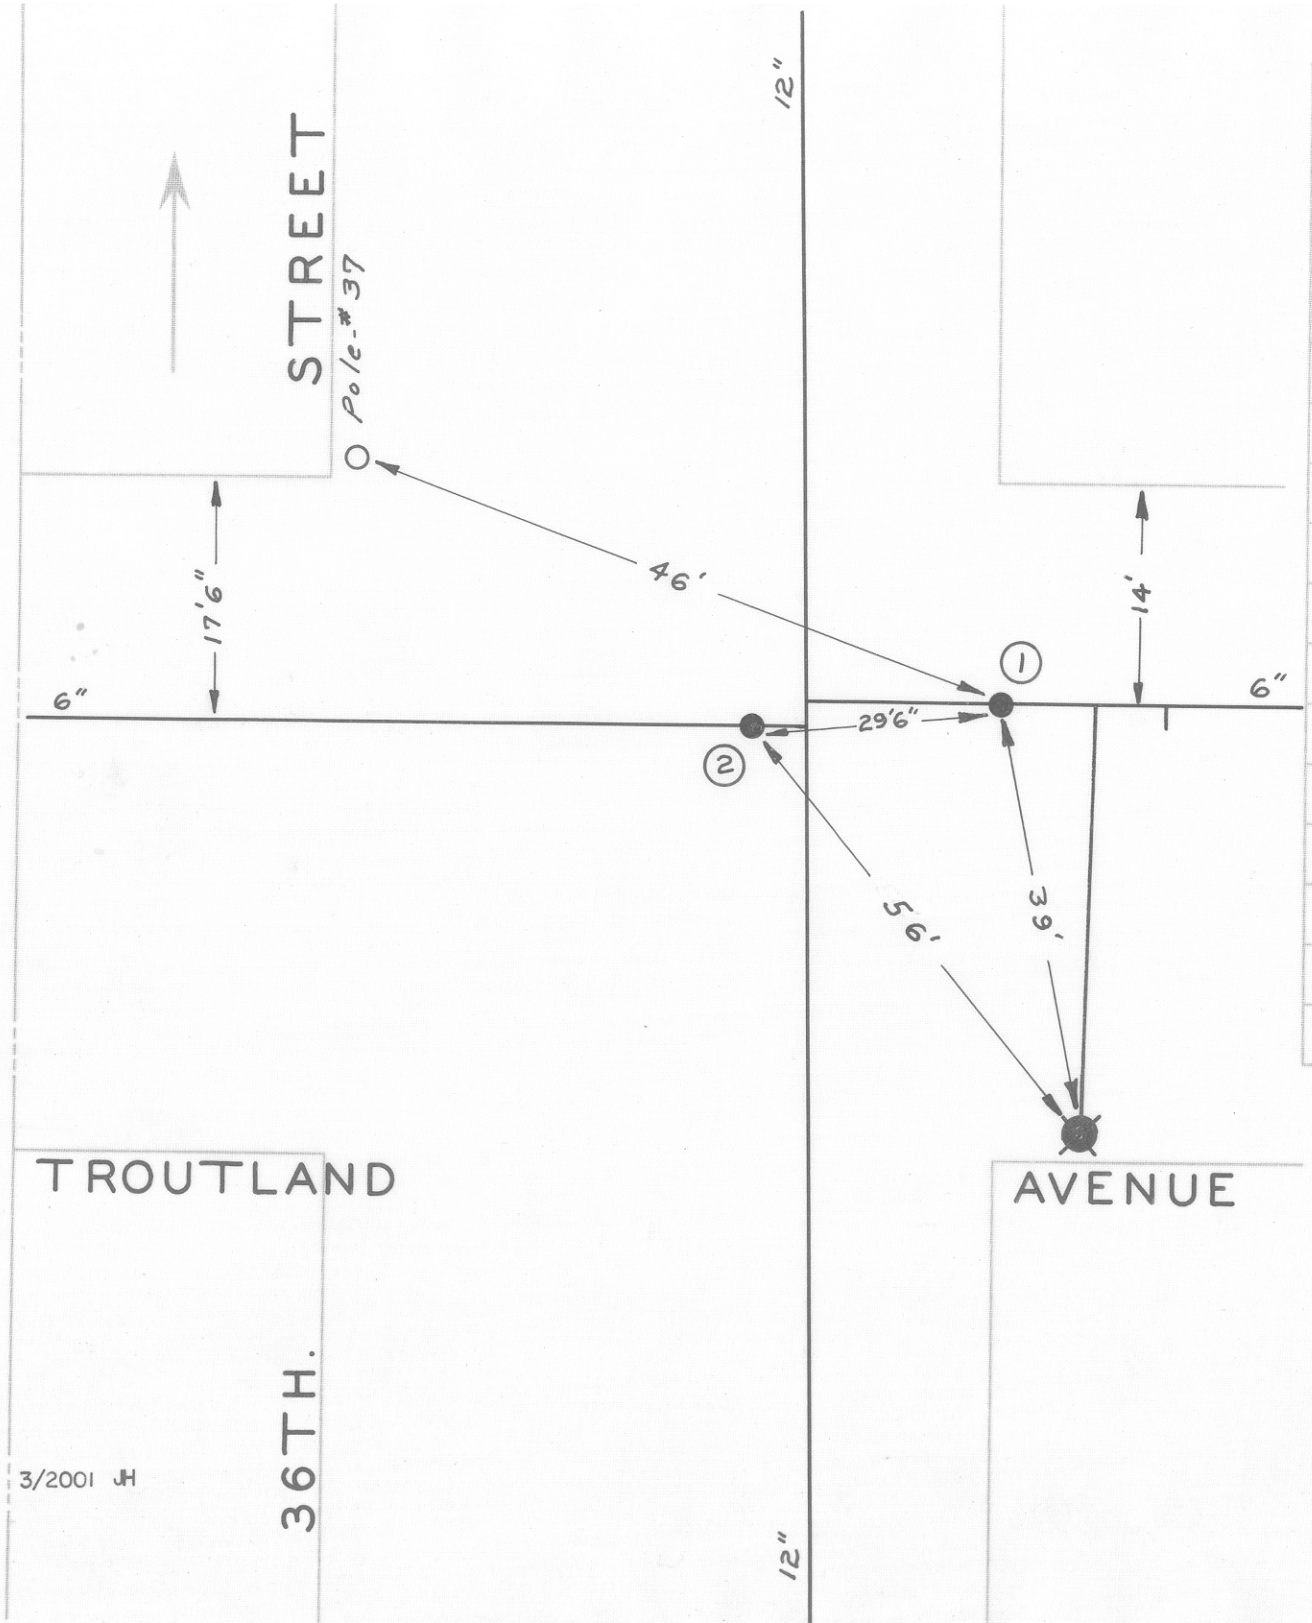

DATE	NO.	SIZE	MAKE	OPEN	TURNS
1952	1	6"	MUELLER	R	20
'58	2	6"	DARLING	R	20
	1	0	EPL		
	2	26'6"-E-WPL			

CITY OF ROANOKE—WATER DEP'T

VALVE DIAGRAM

TROUTLAND AVE. &

36TH. ST. N.W.

SEC. MAP 264 N.W.

DATE PAGE NO.