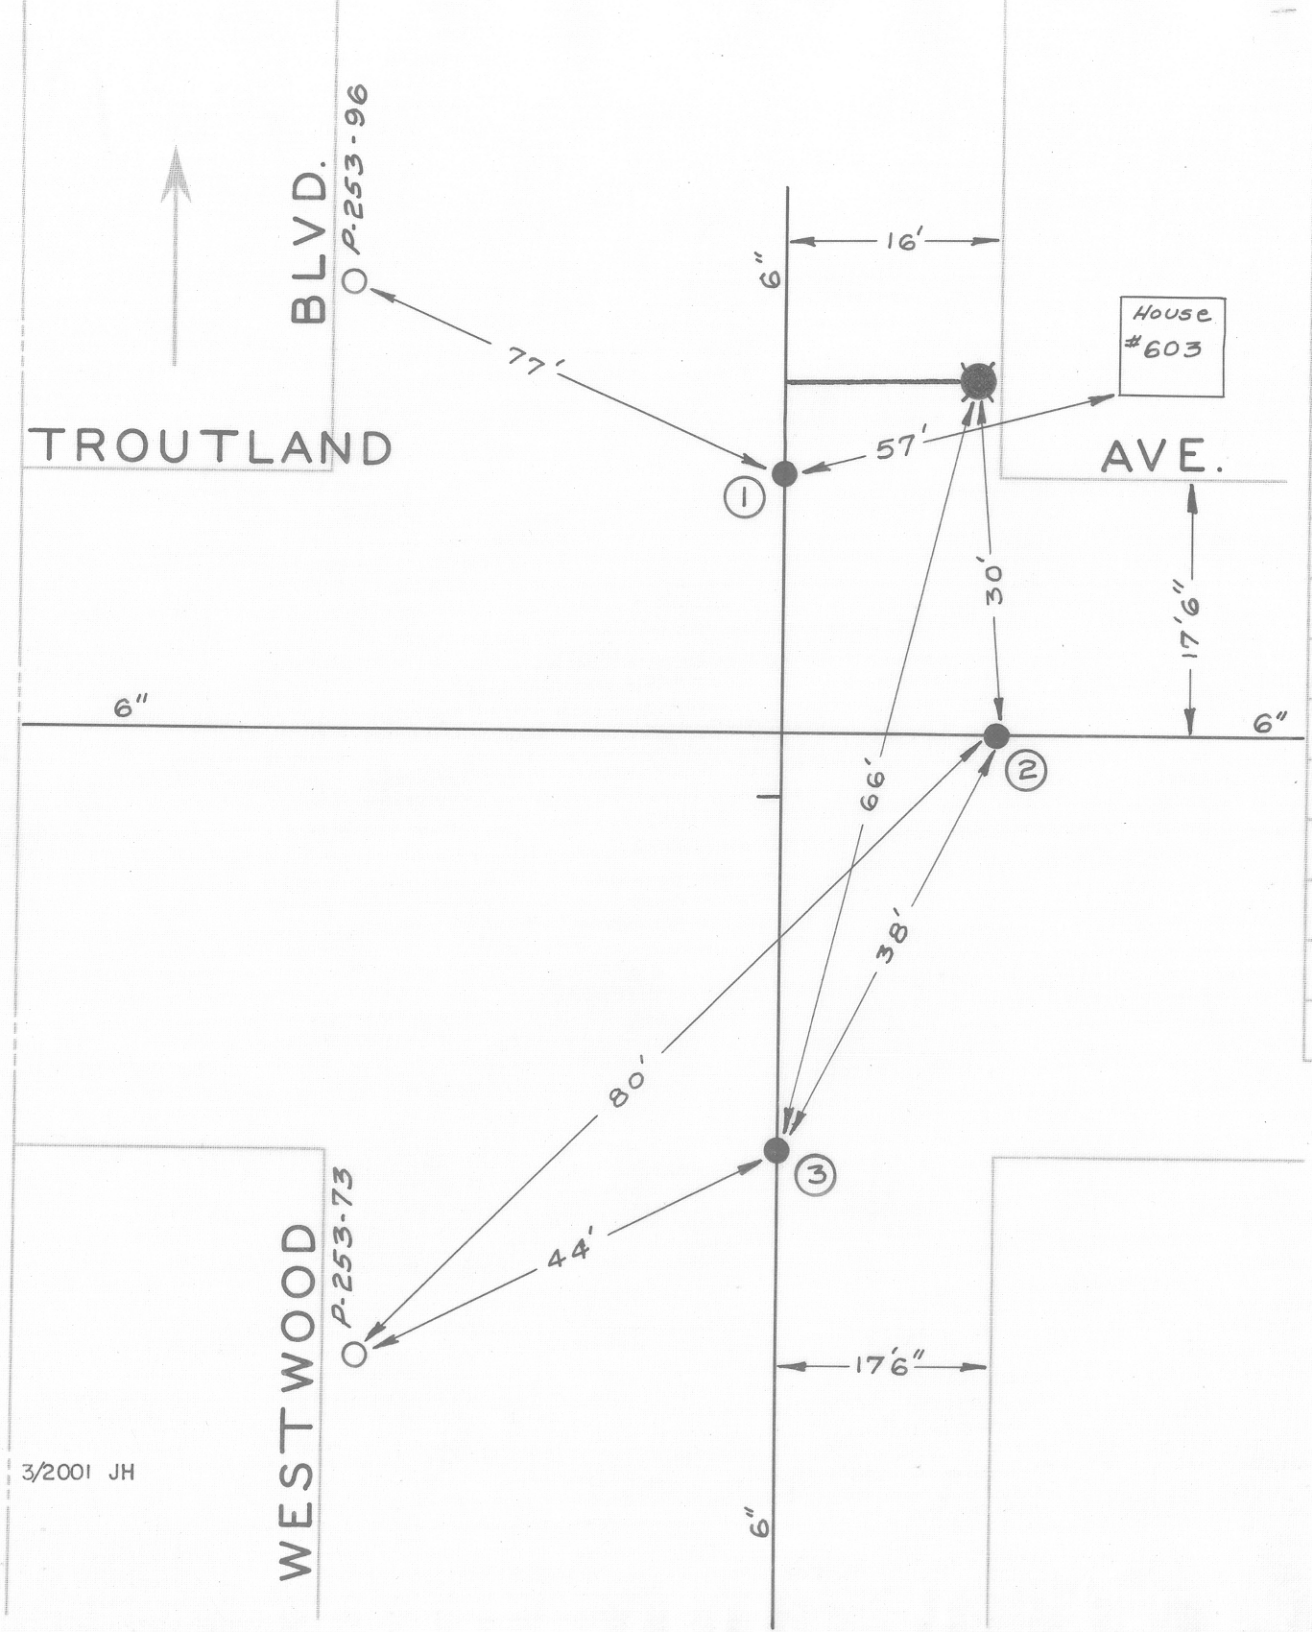

DATE	NO.	SIZE	MAKE	OPEN	TURNS
'57	1	6"	MUELLER	R	
'59	2	6"	MUELLER	R	
'59	3	6"	MUELLER	R	
	1	0	NPL		
	2	0	EPL		
	3	0	SPL		

3/2001 JH

CITY OF ROANOKE—WATER DEP'T

VALVE DIAGRAM

TROUTLAND AVE. &

WESTWOOD BLVD. N.W.

SEC. MAP 264 N.W.

DATE PAGE NO.